


T. 41 S., R. 9 W., W. M.

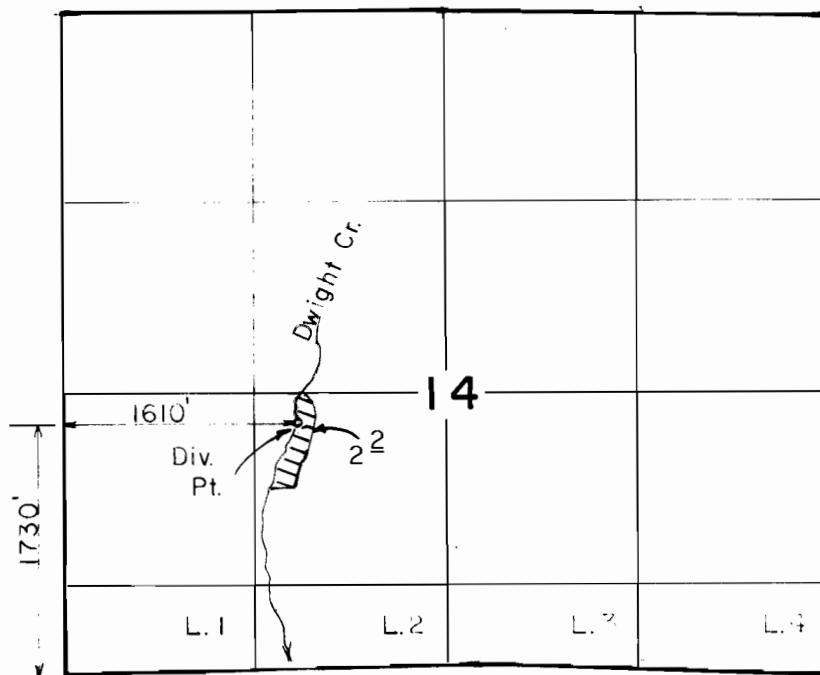

CALIFORNIA

Scale: 1" = 1320'

FINAL PROOF SURVEY UNDER

Application No. 61880.. Permit No. 46255....
IN NAME OF

RONALD W. & CYNTHIA L. HANCOCK

Surveyed APR. 11 1988, by B. S. JAMES.....