


T. 34 S., R. 11 W., W.M.

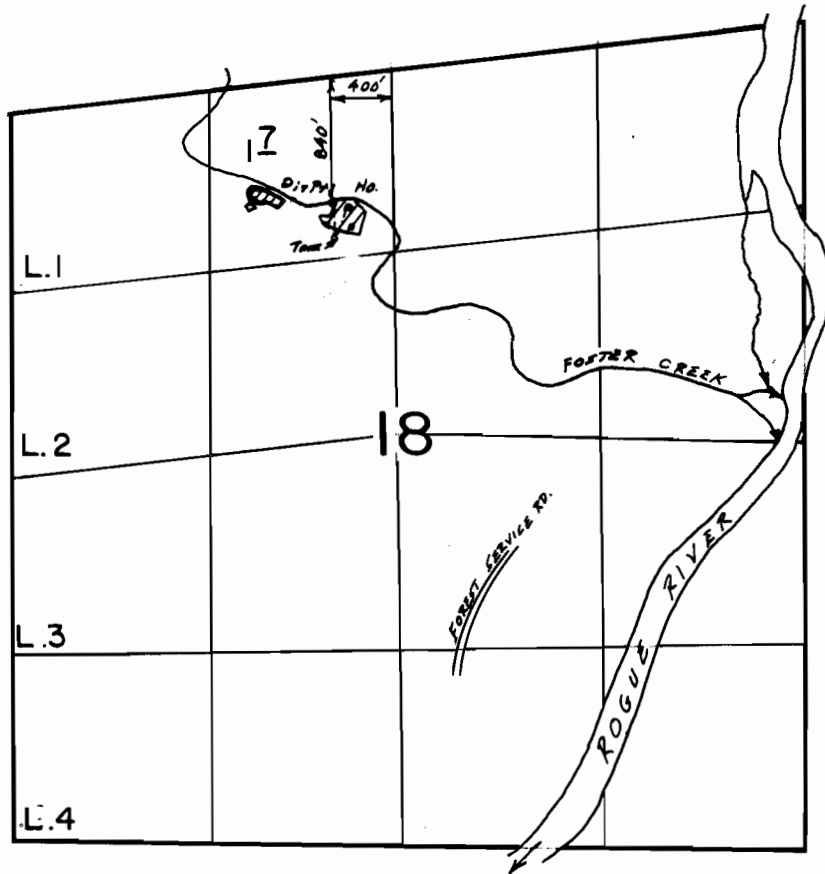

Scale 1" = 1320'

FINAL PROOF SURVEY UNDER

Application No. 62829 Permit No. 46600
IN NAME OF

DAVID F. and SUSAN E. WERSCHKUL

Surveyed July 30, 1989, by B.S. JAMES