


T. 38 S., R. 8 W., W. M.

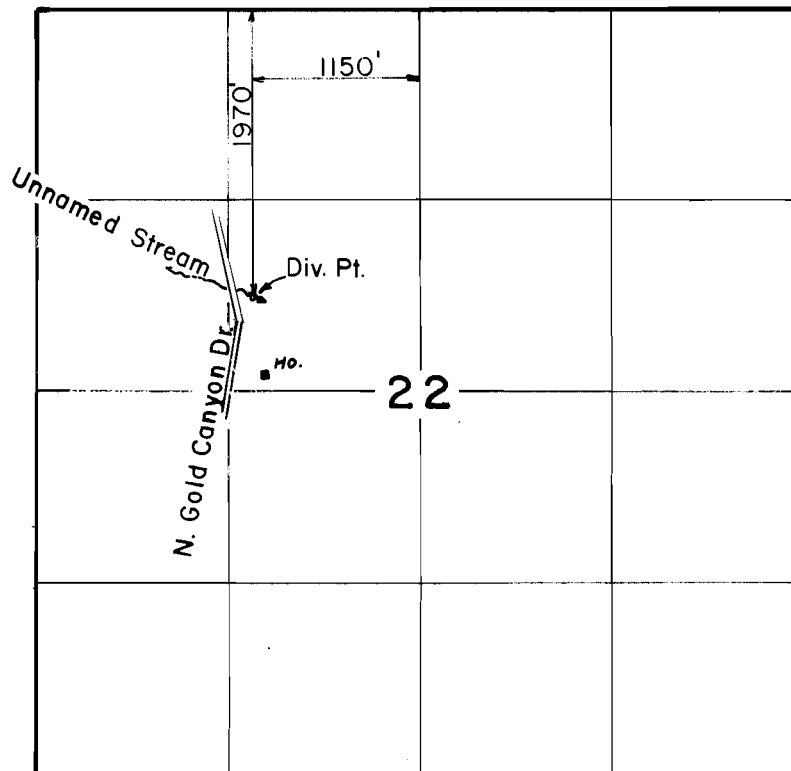

Scale: 1" = 1320'

FINAL PROOF SURVEY
UNDER

Application No. ~~63835~~ Permit No. ~~47515~~....
IN NAME OF

.....DAWN.....ANDERSON.....

Surveyed APR. 18. 1988., by B.S. JAMES...