


T. 38 S., R. 8 W., W. M.

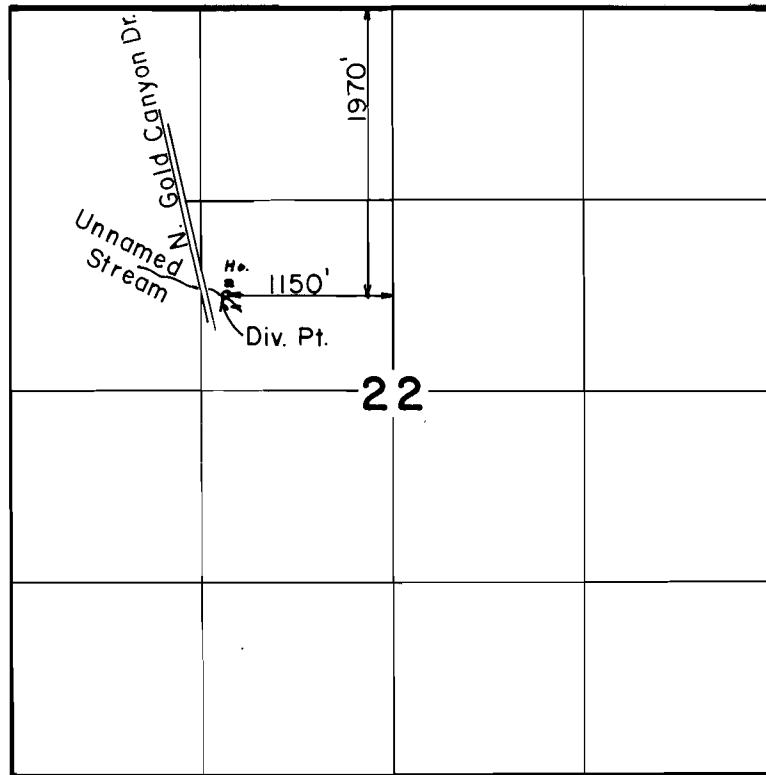

Scale: 1" = 1320'

FINAL PROOF SURVEY
UNDER

Application No. 63836 Permit No. 47516....
IN NAME OF

.....S.U.M.A.....S.H.A.A.Z.M.U.N.D.A.....

Surveyed APR. 18. 1988., by B..S...JAMES...