


T. 41 S., R. 9 W., W. M.

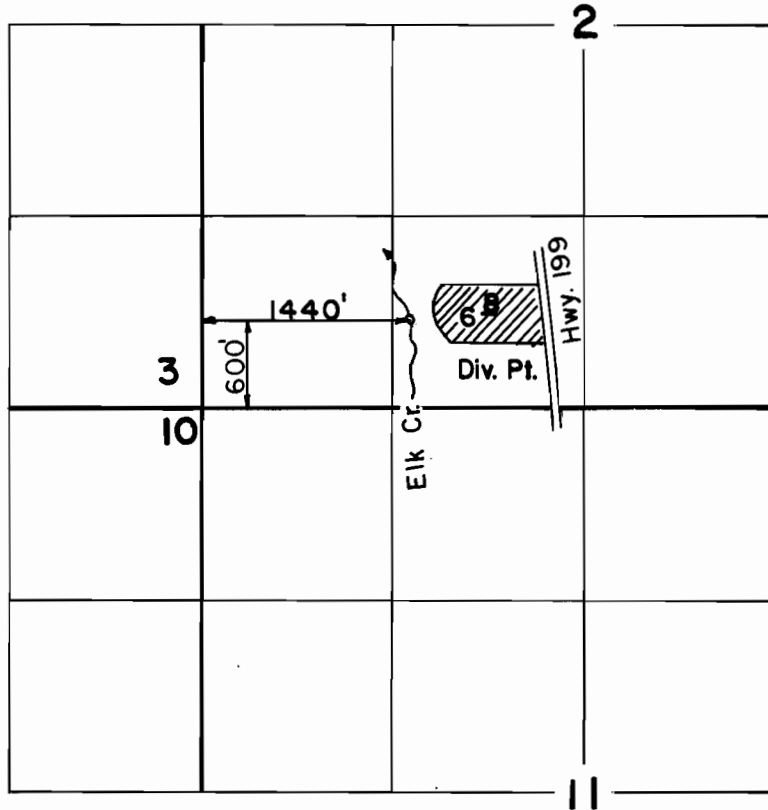

Scale: 1" = 1320'

FINAL PROOF SURVEY
UNDER

Application No. ~~6.5.5.6~~ Permit No. 4.7.7.31...
IN NAME OF

GORDON & JEAN ROBERTSON

Surveyed APR. 13. 1988., by B. S. JAMES...