


47584
66897

47584

T.39S., R.24E., W.M.

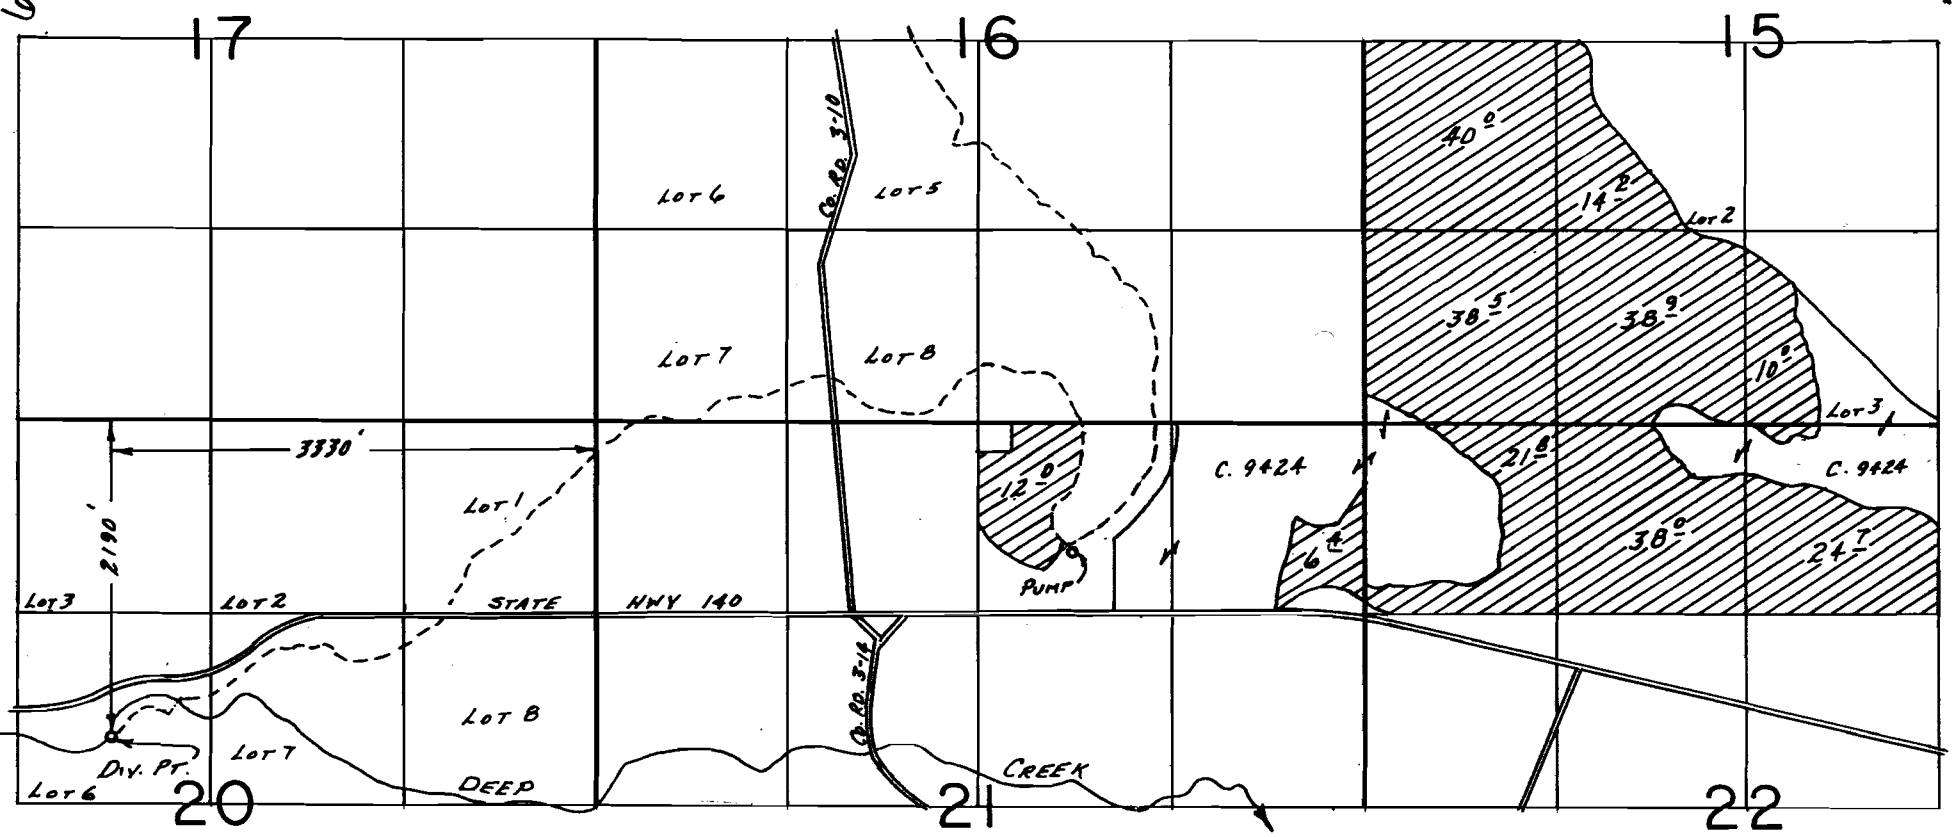

SCALE: 1" = 1320'

FINAL PROOF SURVEY
UNDER

Application No. 65159 Permit No. 47584
IN NAME OF Cert. # 66897

FLORENCE CLELAND % GLENN CLELAND

Surveyed Nov. 28 1990, by B.W. BISHOP,