






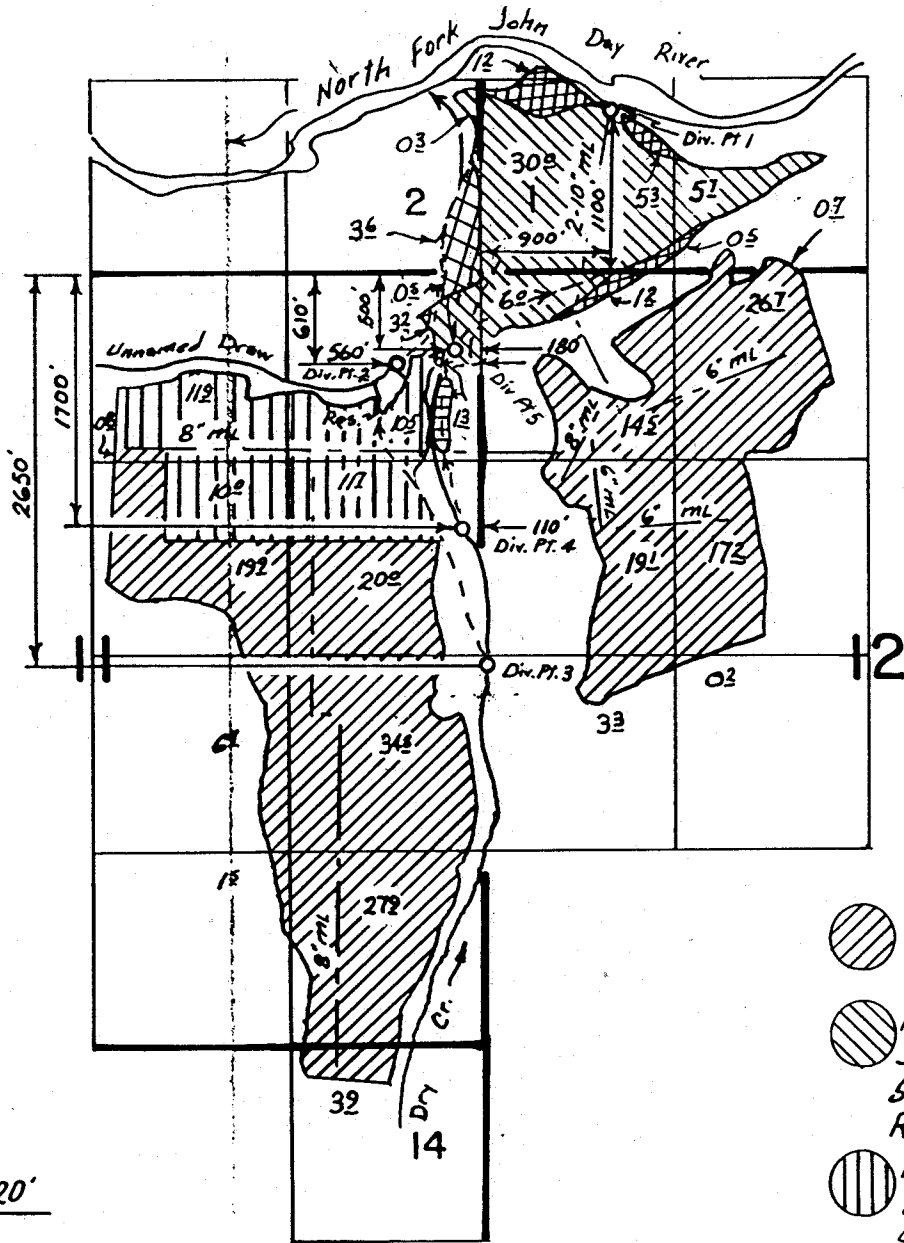


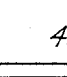



T.9S., R.27E., W.M.

C-66898 P-49608
P-37727
C-66875



Scale: 1" = 1320'

-  Primary - North Fork John Day River, P# 37727
-  Primary - North Fork John Day River, C# 37663
-  Supplemental - Dry Creek, Reservoir, P# 49608
-  Primary - North Fork John Day River
-  Supplemental - Reservoir P# 49608
-  Primary - North Fork John Day River
-  Supplemental - Dry Creek, Reservoir P# 49608
-  Primary - Dry Creek
-  Supplemental - Reservoir P# 49608
-  Primary - Dry Creek
-  Supplemental - unnamed draw, North Fork John Day River, Reservoir P# 49608

FINAL PROOF SURVEY

UNDER

52616 37727

65245 49608

Application No. R65249 Permit No. R10604
IN NAME OF

.....PHILIP W. MURPHY.....

Surveyed 2-27 1991, by K. Kemp.....