



SECTION 10, T.1S., R.2W., W.M.

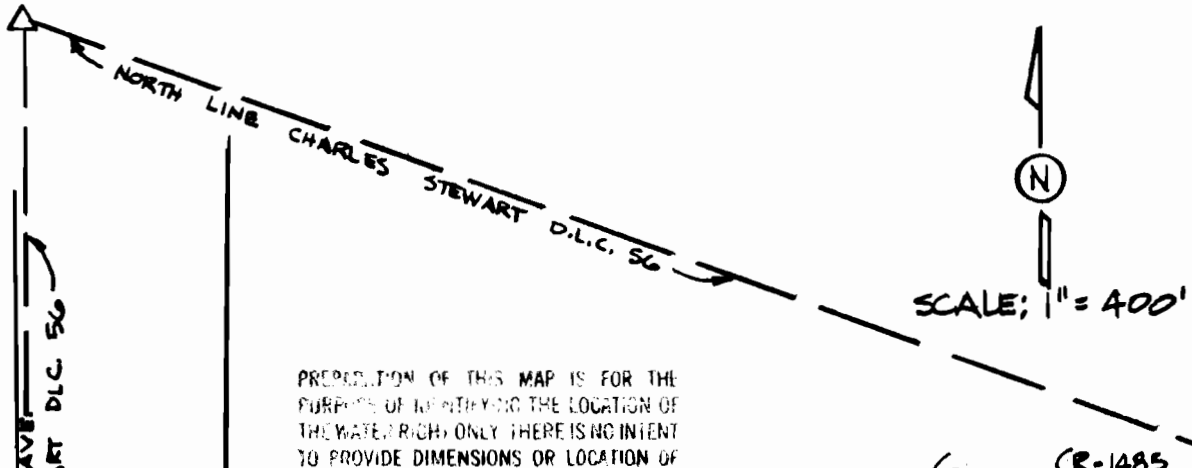

PREPARATION OF THIS MAP IS FOR THE PURPOSE OF IDENTIFYING THE LOCATION OF THE WATER RIGHT ONLY. THERE IS NO INTENT TO PROVIDE DIMENSIONS OR LOCATION OF PROPERTY OWNERSHIP LINES.

PERMIT { R-1485  
          { 22166  
CERT. { 27641  
          { 27642

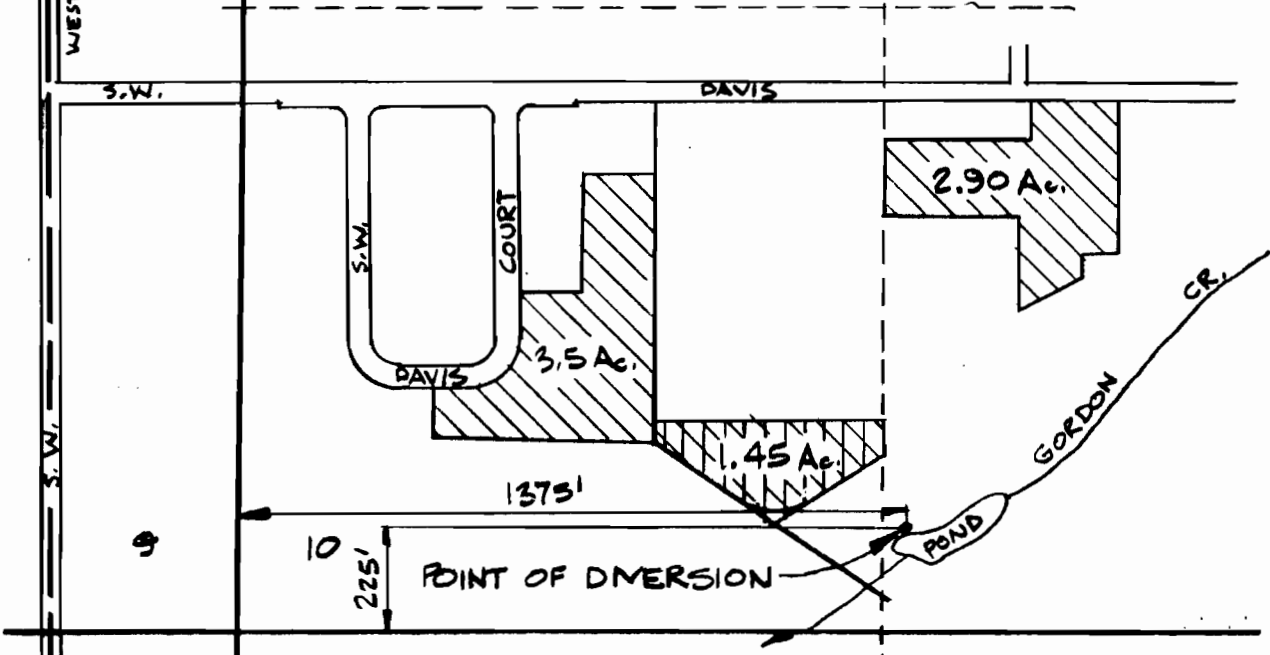

**FINAL PROOF SURVEY**  
 UNDER  
 APPLICATION NO. 69588 PERMIT NO. 50530  
 SURVEYED 3/29/91 BY: W. RICHARD VERBOORT

**VERBOORT ENGINEERING**  
 AGRICULTURE • CIVIL • WATER RESOURCES  
 HILLSBORO, OREGON

designed by WRV date 4/91  
 drawn by LER date 4/91  
 checked by WRV date 4/91  
 drawing no. 21A-06  
 sheet no. 1/1

PATRICIA R. SERRURIER  
 837 N.W. ALBERMARELE  
 PORTLAND, OR 97210