


T. 5 S. R. 1 W. W. M.

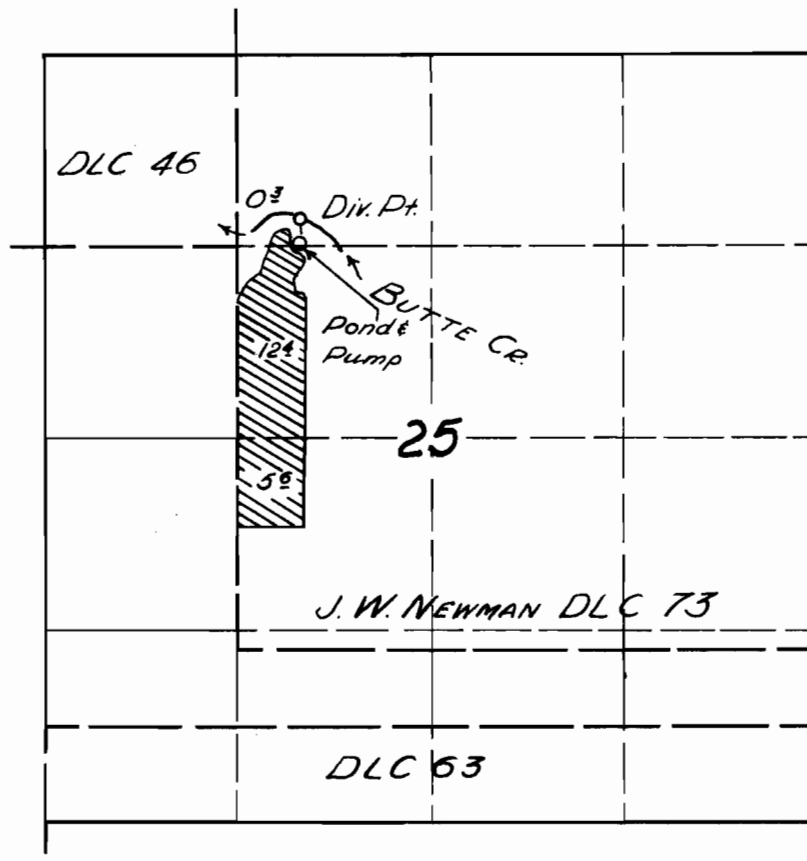

FINAL PROOF SURVEY

UNDER

Application No. 25211 Permit No. 19816

IN NAME OF

ANDREW DUMMER

Surveyed 12 Mar 1957, by C. C. Bartels