

Form AI-187
March 1961

UNITED STATES
DEPARTMENT OF THE INTERIOR
BUREAU OF LAND MANAGEMENT


SECTION
32

Oregon State Water Filings

NE $\frac{1}{4}$ NW $\frac{1}{4}$

TOWNSHIP 27S, RANGE 25E, W. M.

Tied in with aerial photos and O. S. H. D. Quad Maps.

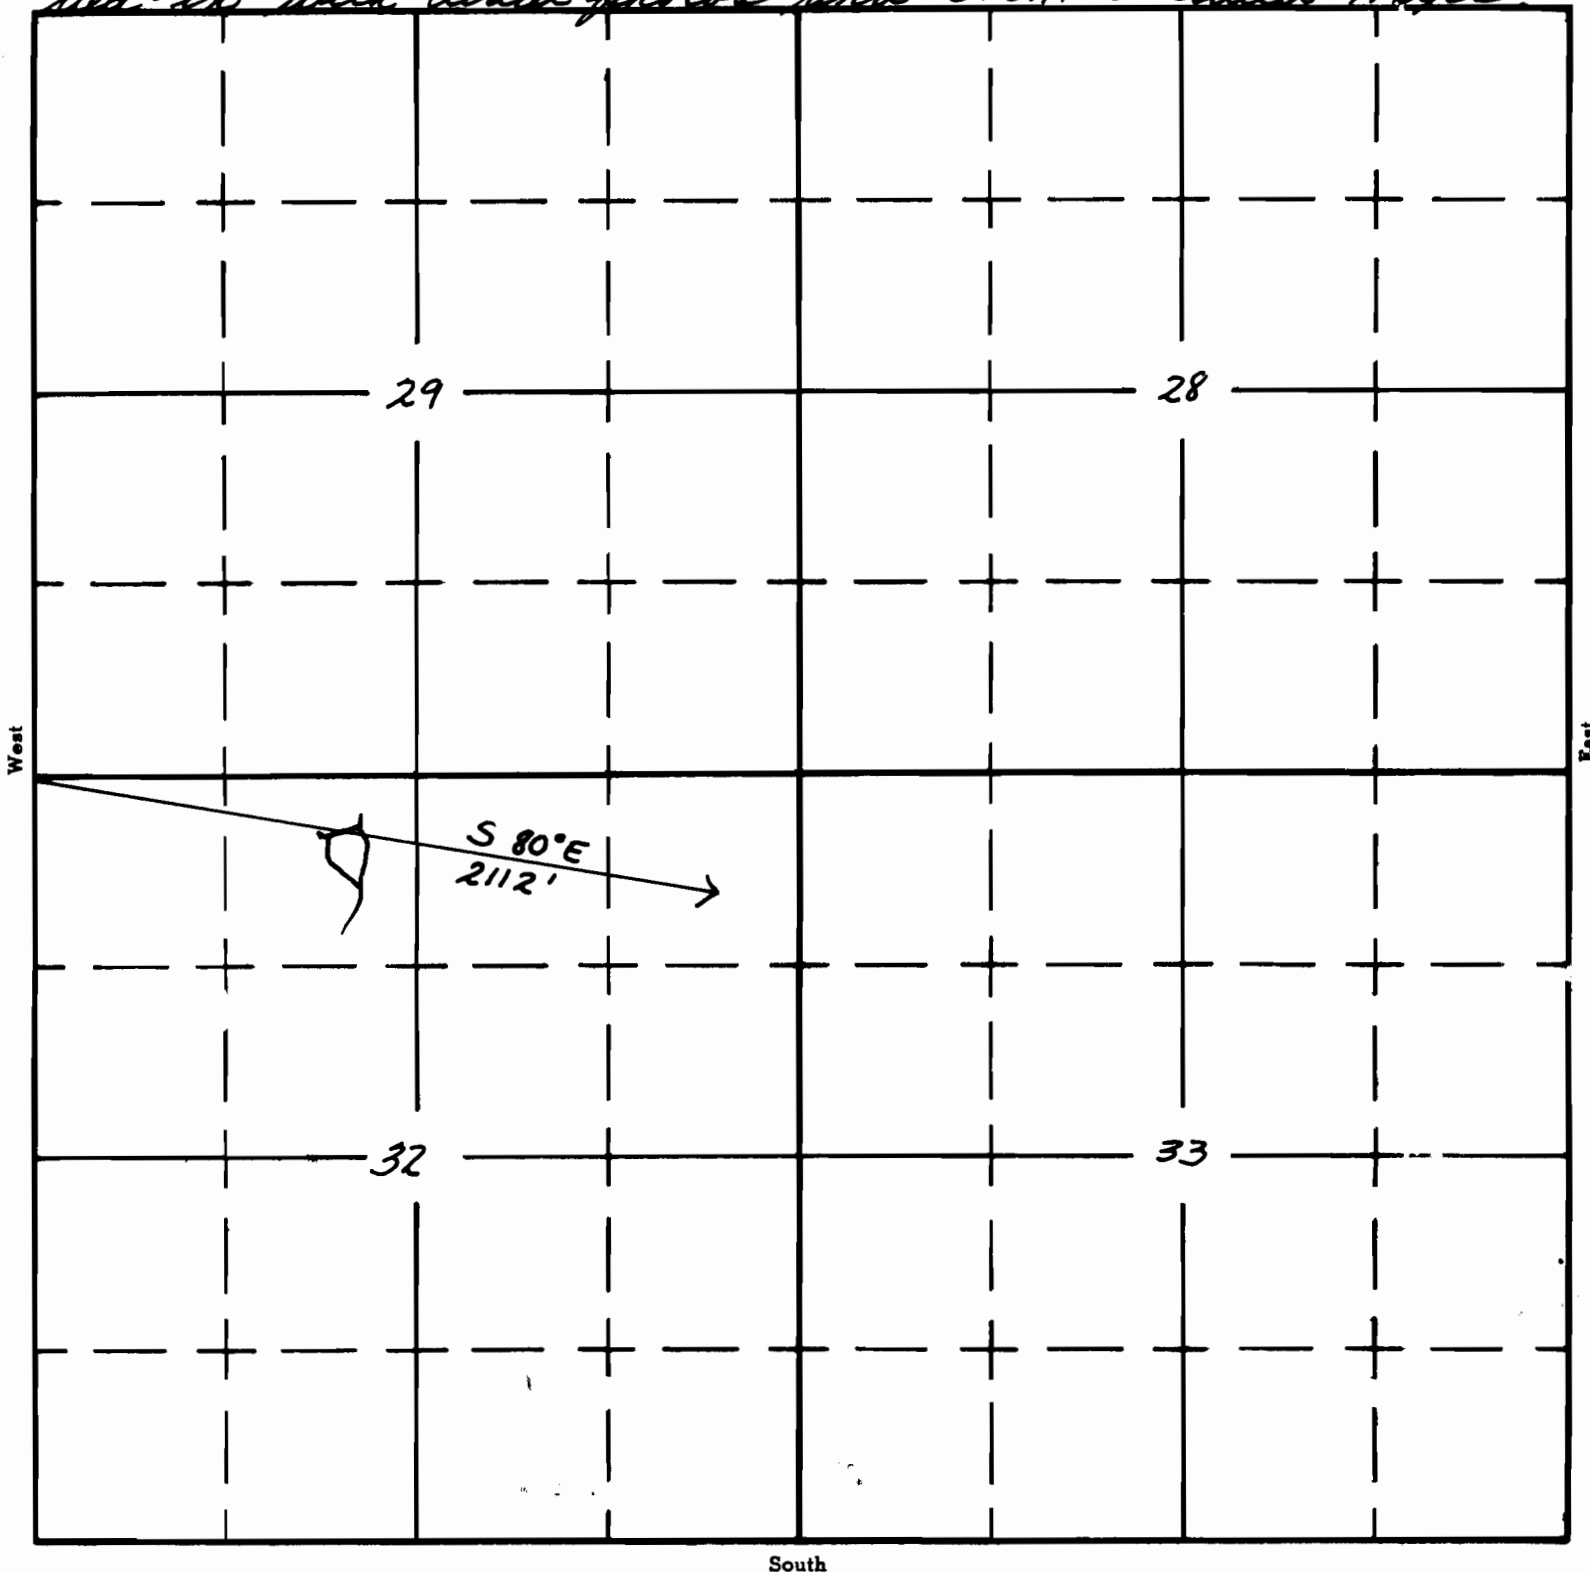

APPLICATION No. R-35725
PERMIT No. R-4058