

UNITED STATES
DEPARTMENT OF THE INTERIOR
BUREAU OF LAND MANAGEMENT

R-40205
R-4077
66912

SECTION


31

Oregon State Water Filings

SE $\frac{1}{4}$ NW $\frac{1}{4}$

TOWNSHIP 38 S, RANGE 26 E, W. M.

Tied-in with aerial photo^{North} and O.S.H.D. Quad Maps.

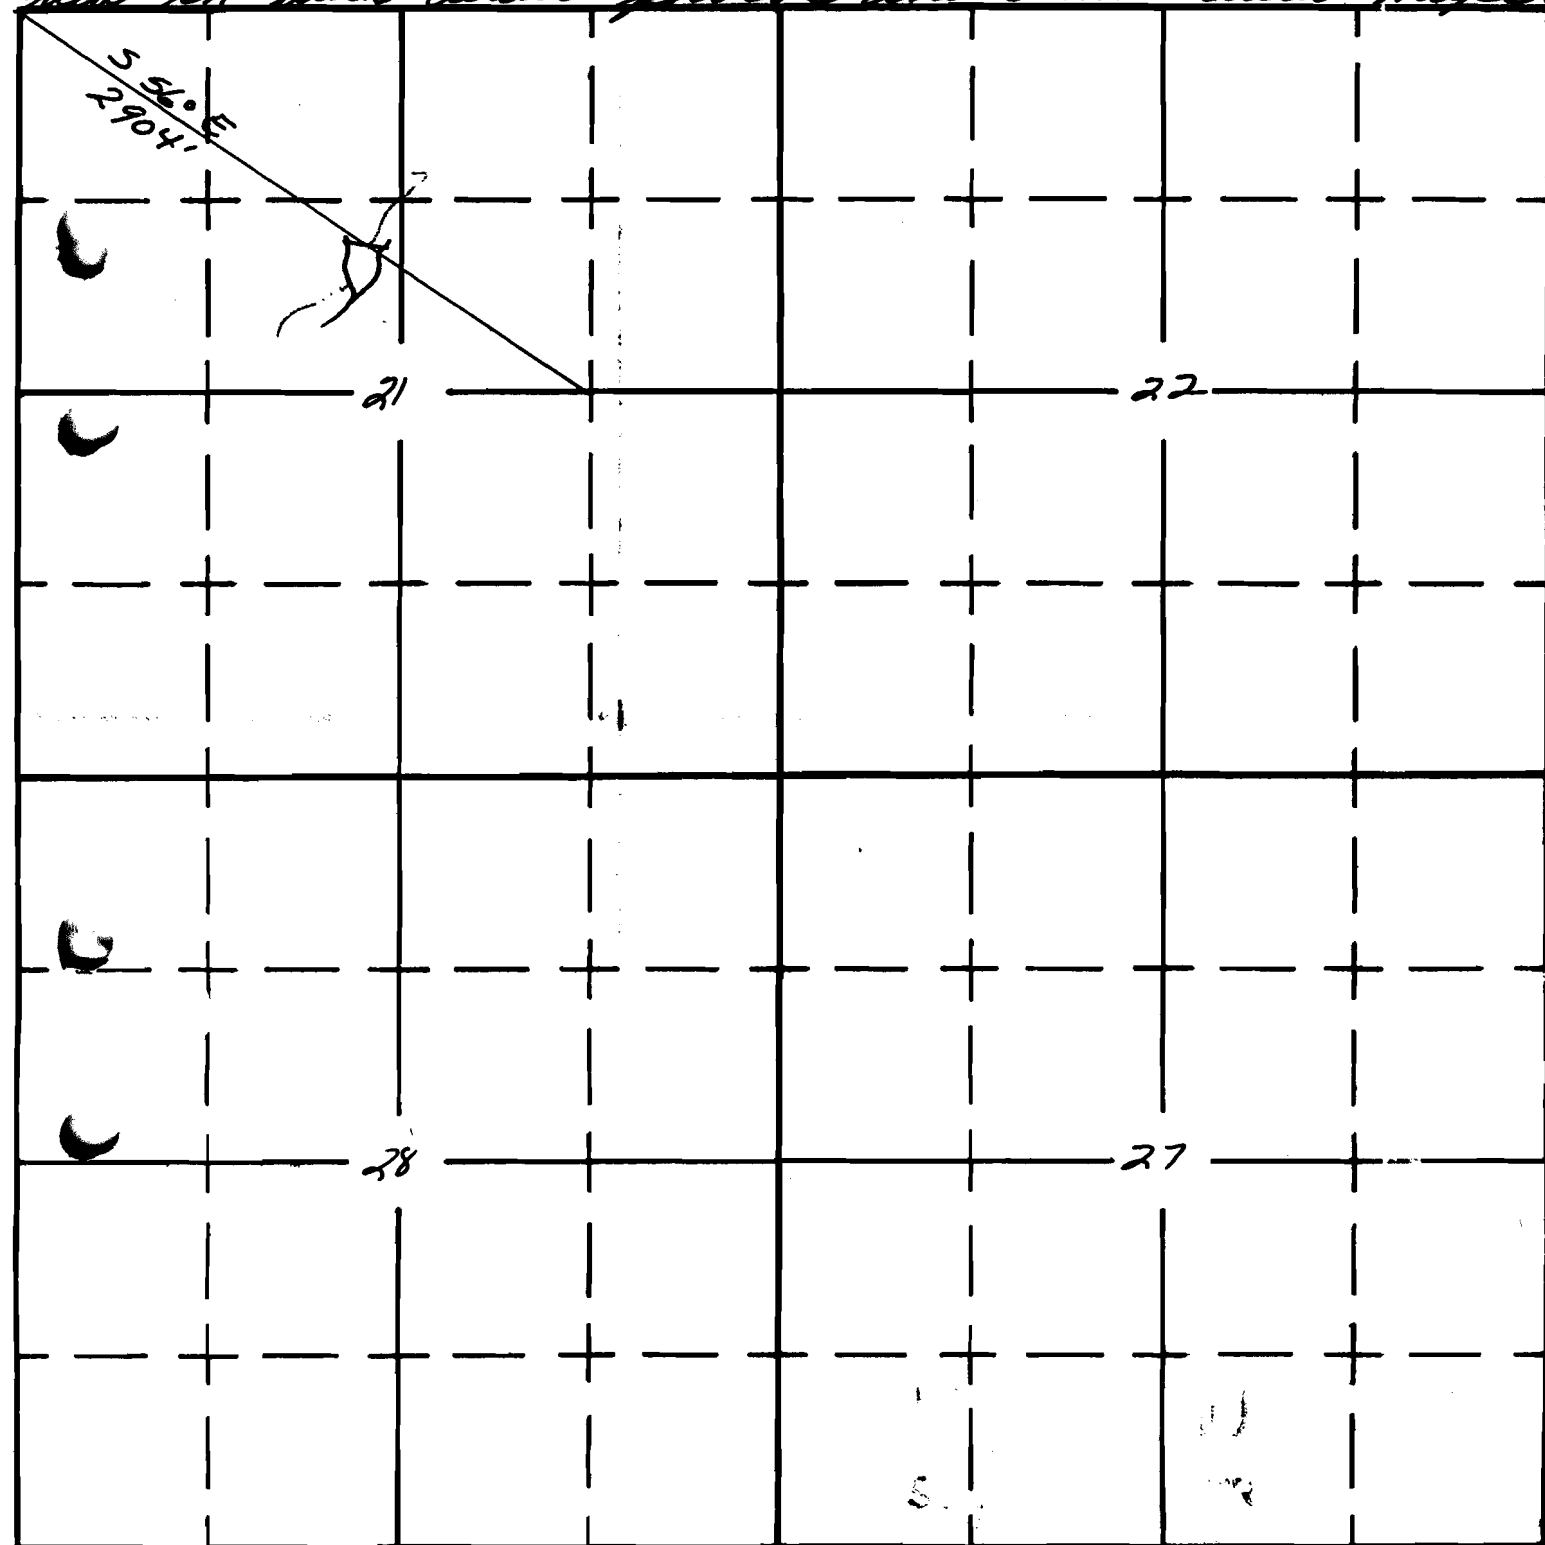

South

APPLICATION No. R-35789

PERMIT No. R-4077