


Form AI-187
March 1961

UNITED STATES
DEPARTMENT OF THE INTERIOR
BUREAU OF LAND MANAGEMENT

R. 4205
66913

SECTION 8
SE 1/4 NW 1/4

Oregon State Water Filings
TOWNSHIP 39S, RANGE 26E, W. M.

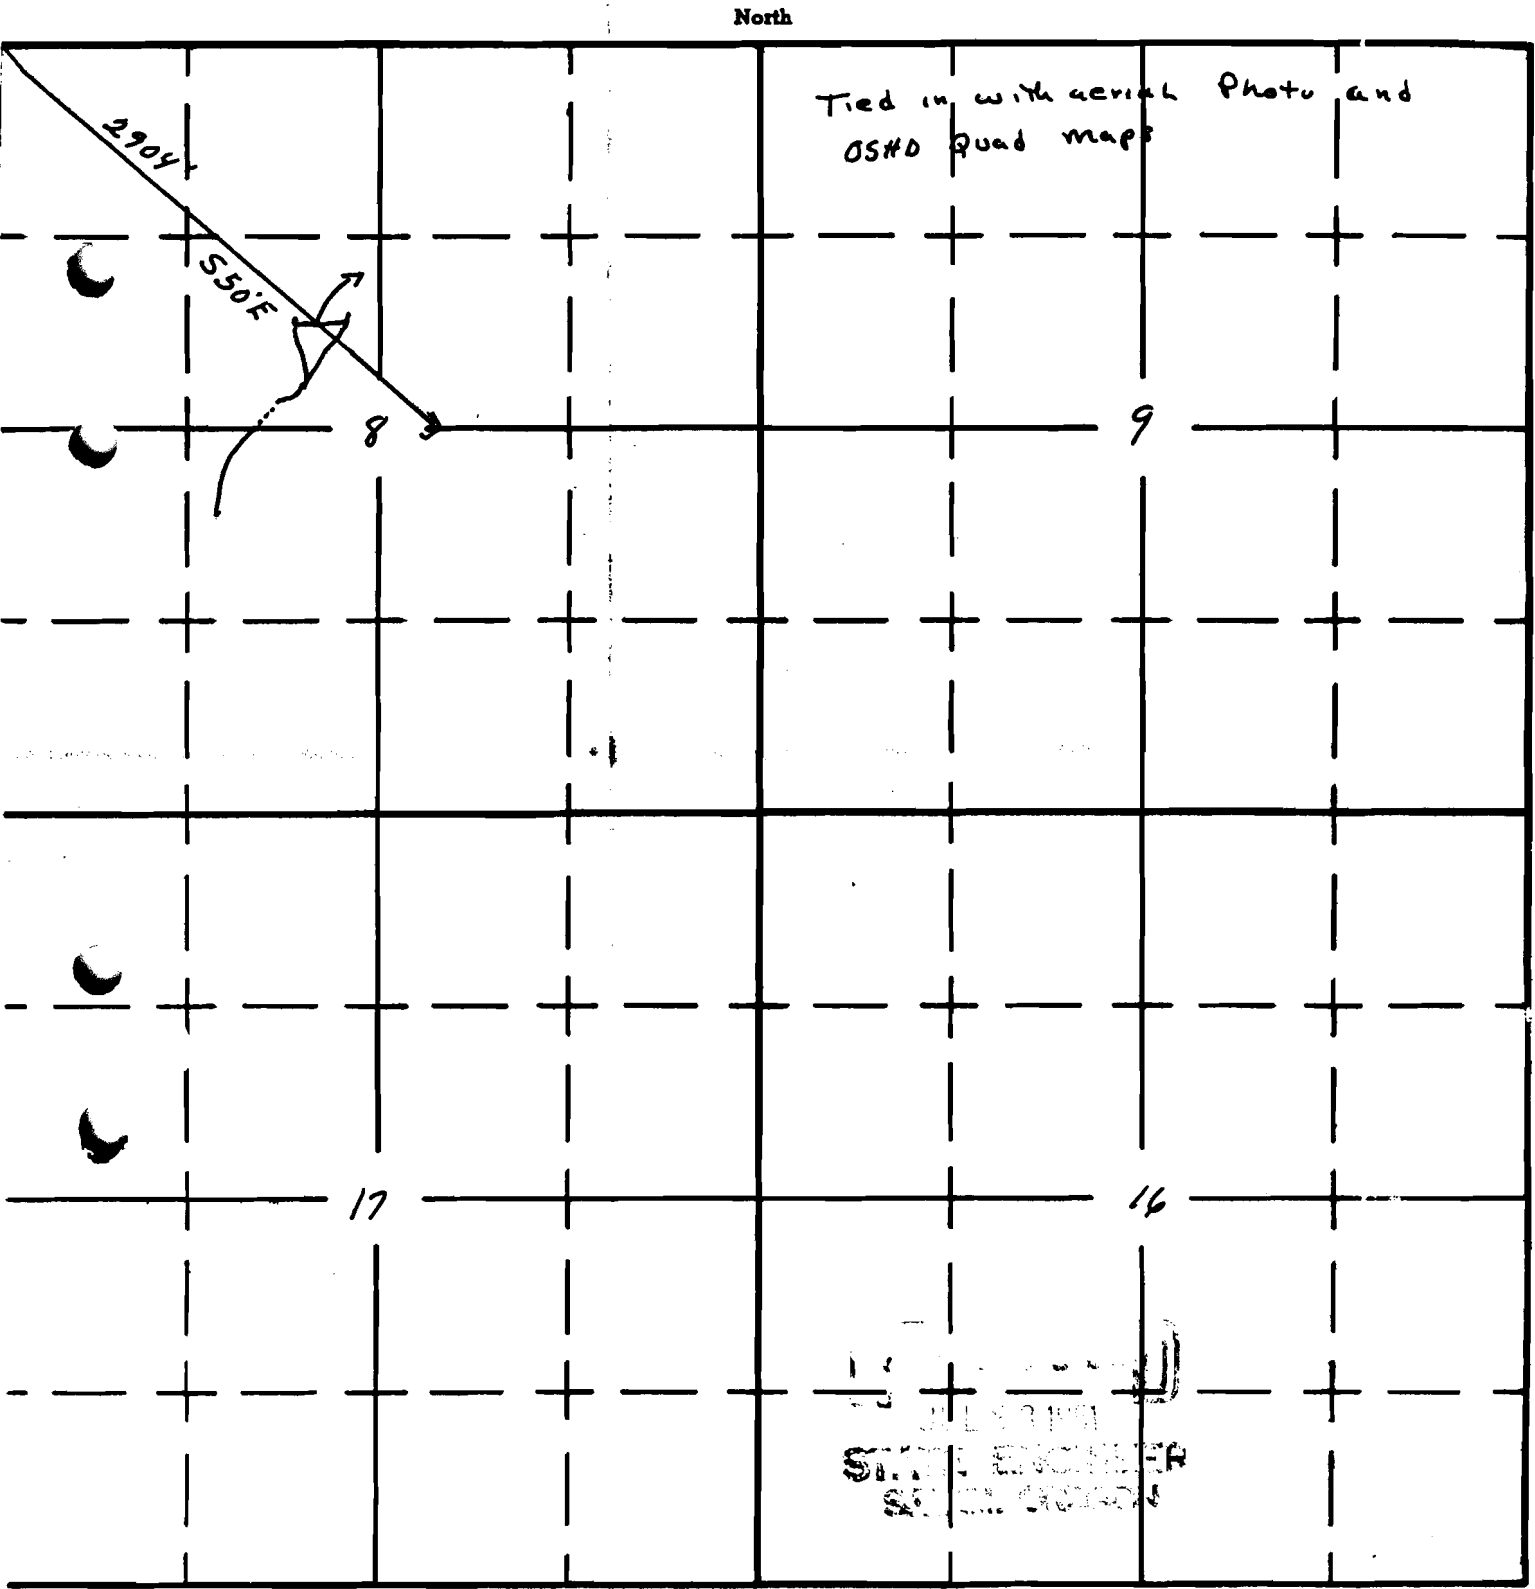

South

APPLICATION No. R-35814
PERMIT No. R-4205