

UNITED STATES
DEPARTMENT OF THE INTERIOR
BUREAU OF LAND MANAGEMENT


SECTION 14

Oregon State Water Filings

SW¹/₄ SW¹/₄

TOWNSHIP 29 S, RANGE 24 E, W. M.

Tied in with aerial photos and O.S.H.D. Quad Maps

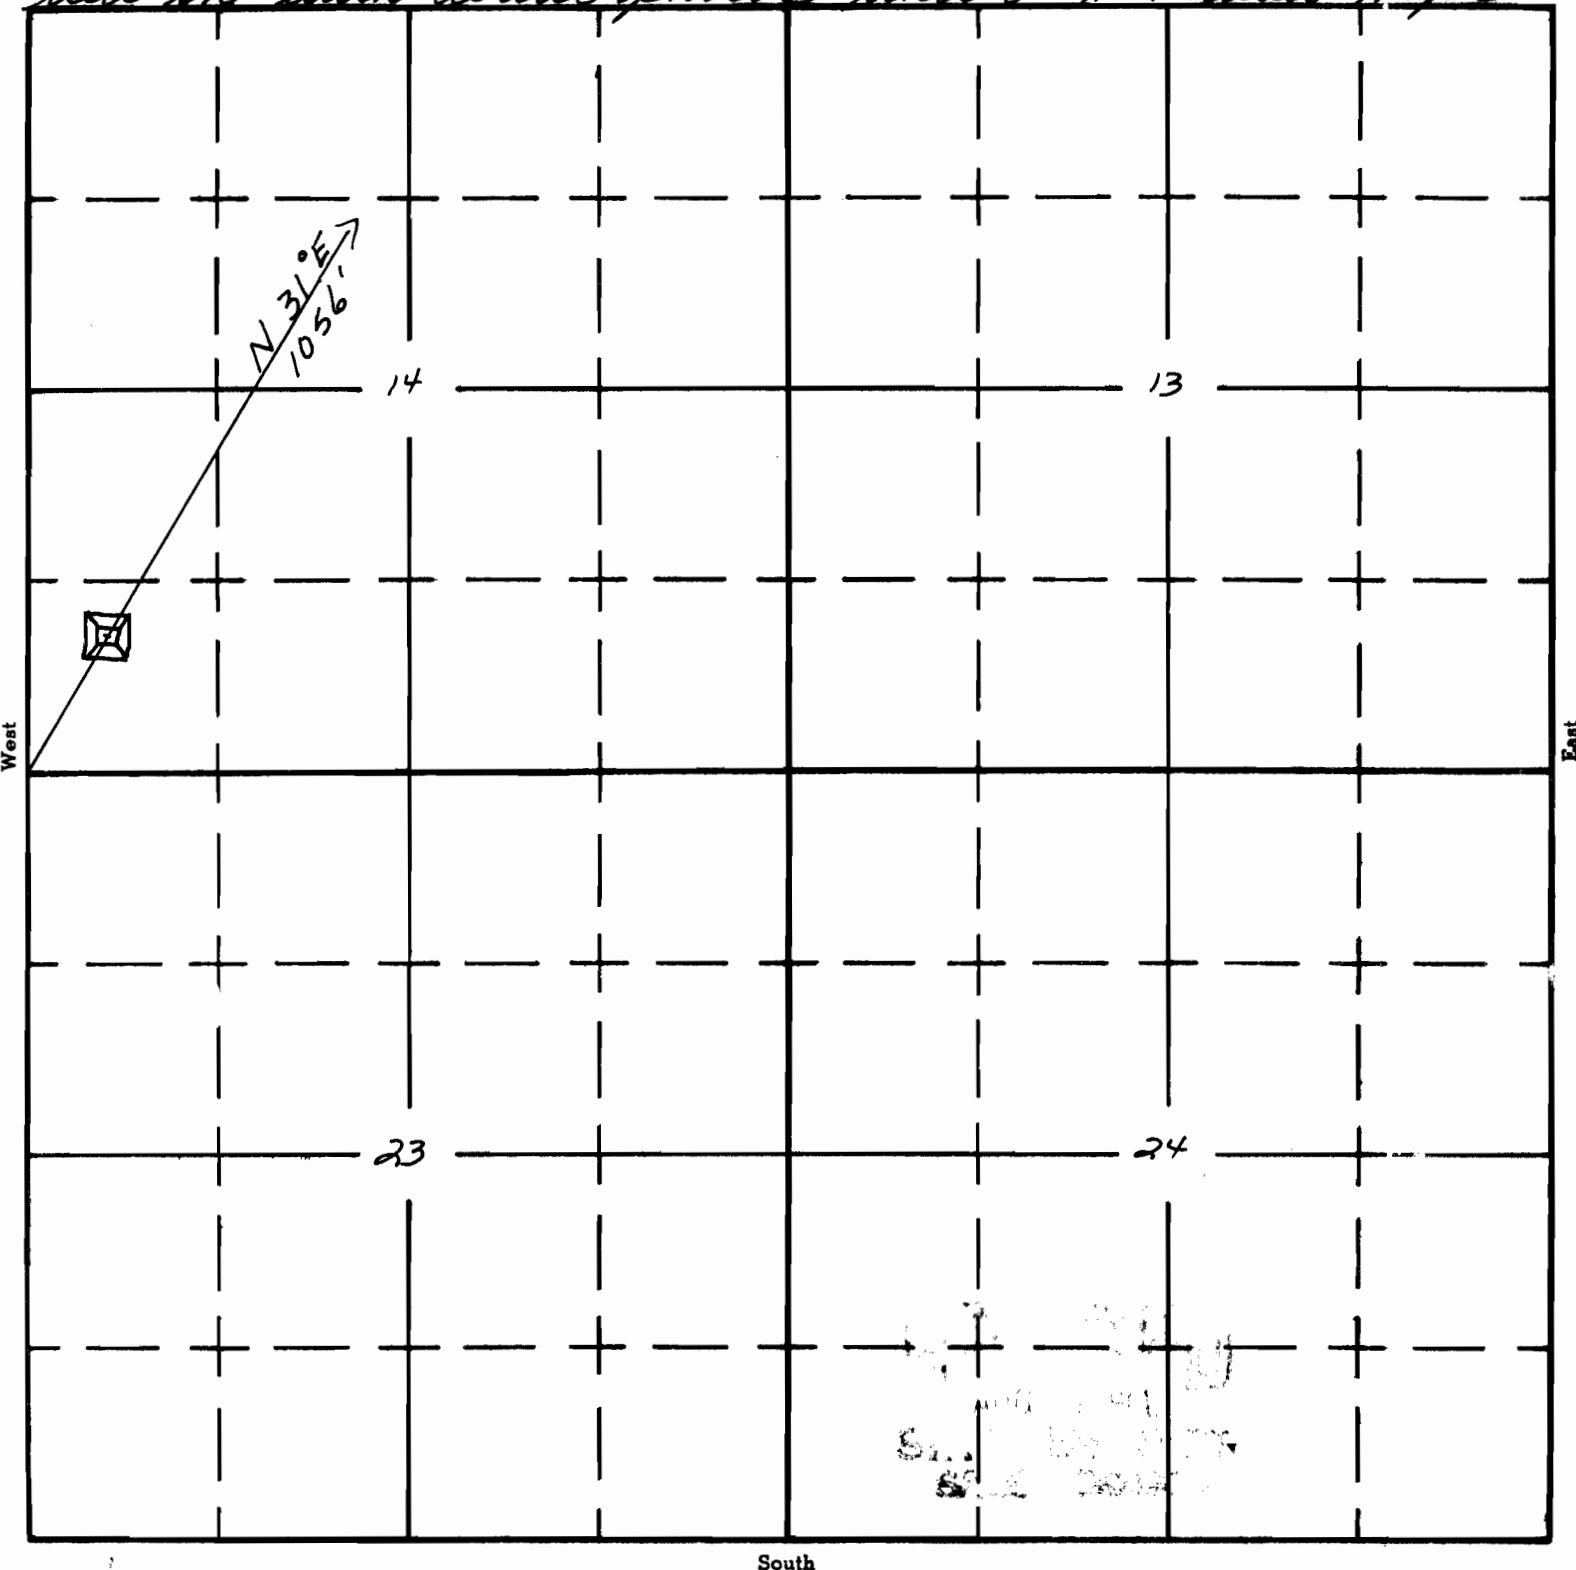

APPLICATION No. R-35943
PERMIT No. R-3721