

Form AI-187
March 1961

UNITED STATES
DEPARTMENT OF THE INTERIOR
BUREAU OF LAND MANAGEMENT

SECTION

34

SE 1/4 NW 1/4

Oregon State Water Filings


TOWNSHIP 28S, RANGE 24E, W. M.

North

Tied in with OS&O Quad maps and aerial photo.

West

East

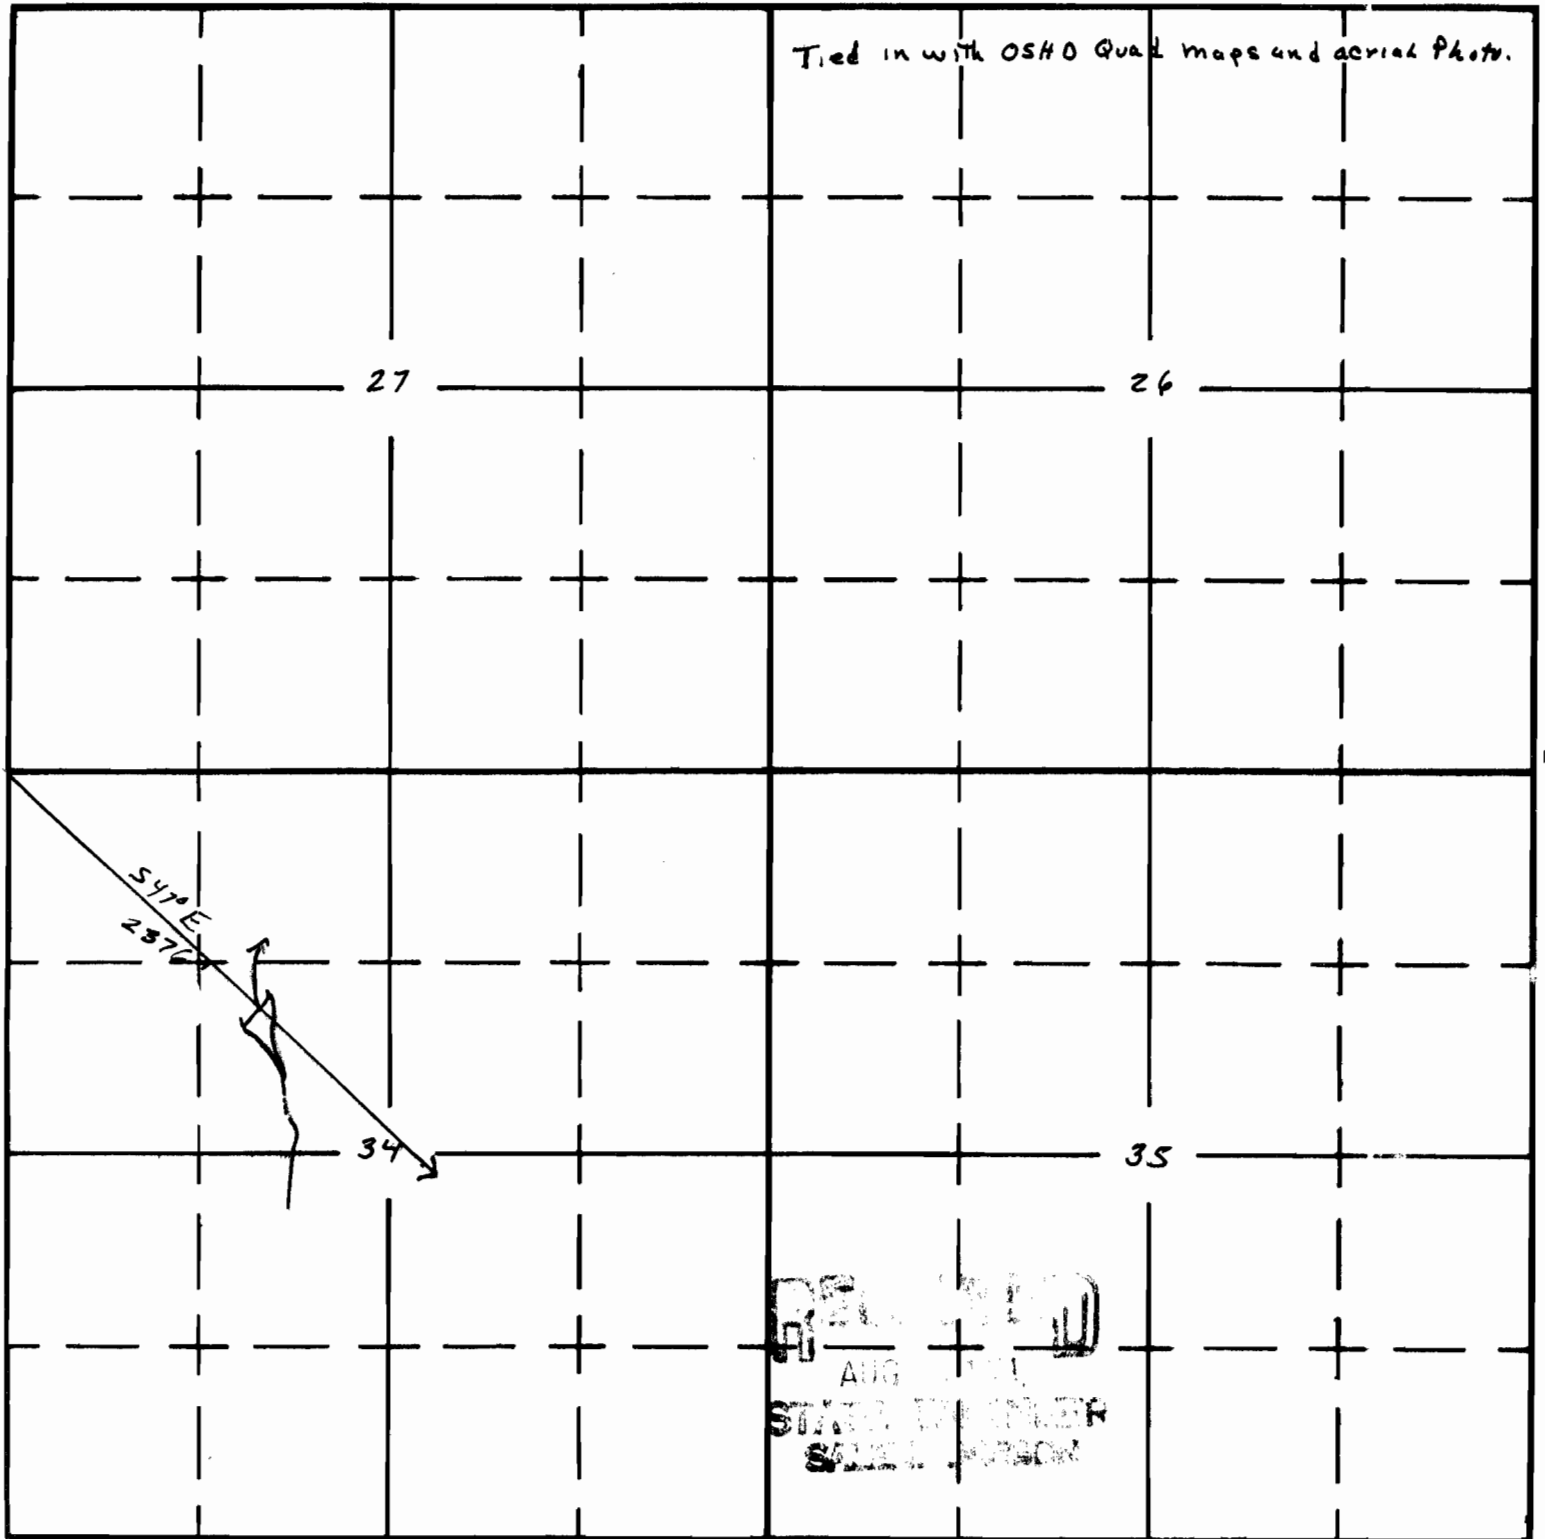

South

APPLICATION No. R-35979
PERMIT No. R-3751