


Form A1-187
March 1961

UNITED STATES
DEPARTMENT OF THE INTERIOR
BUREAU OF LAND MANAGEMENT

SECTION
31
SE 1/4 NE 1/4

Oregon State Water Filings
TOWNSHIP 37 S, RANGE 29 E, W. M.

North *Tied in with aerial photo and OS40 quad maps.*

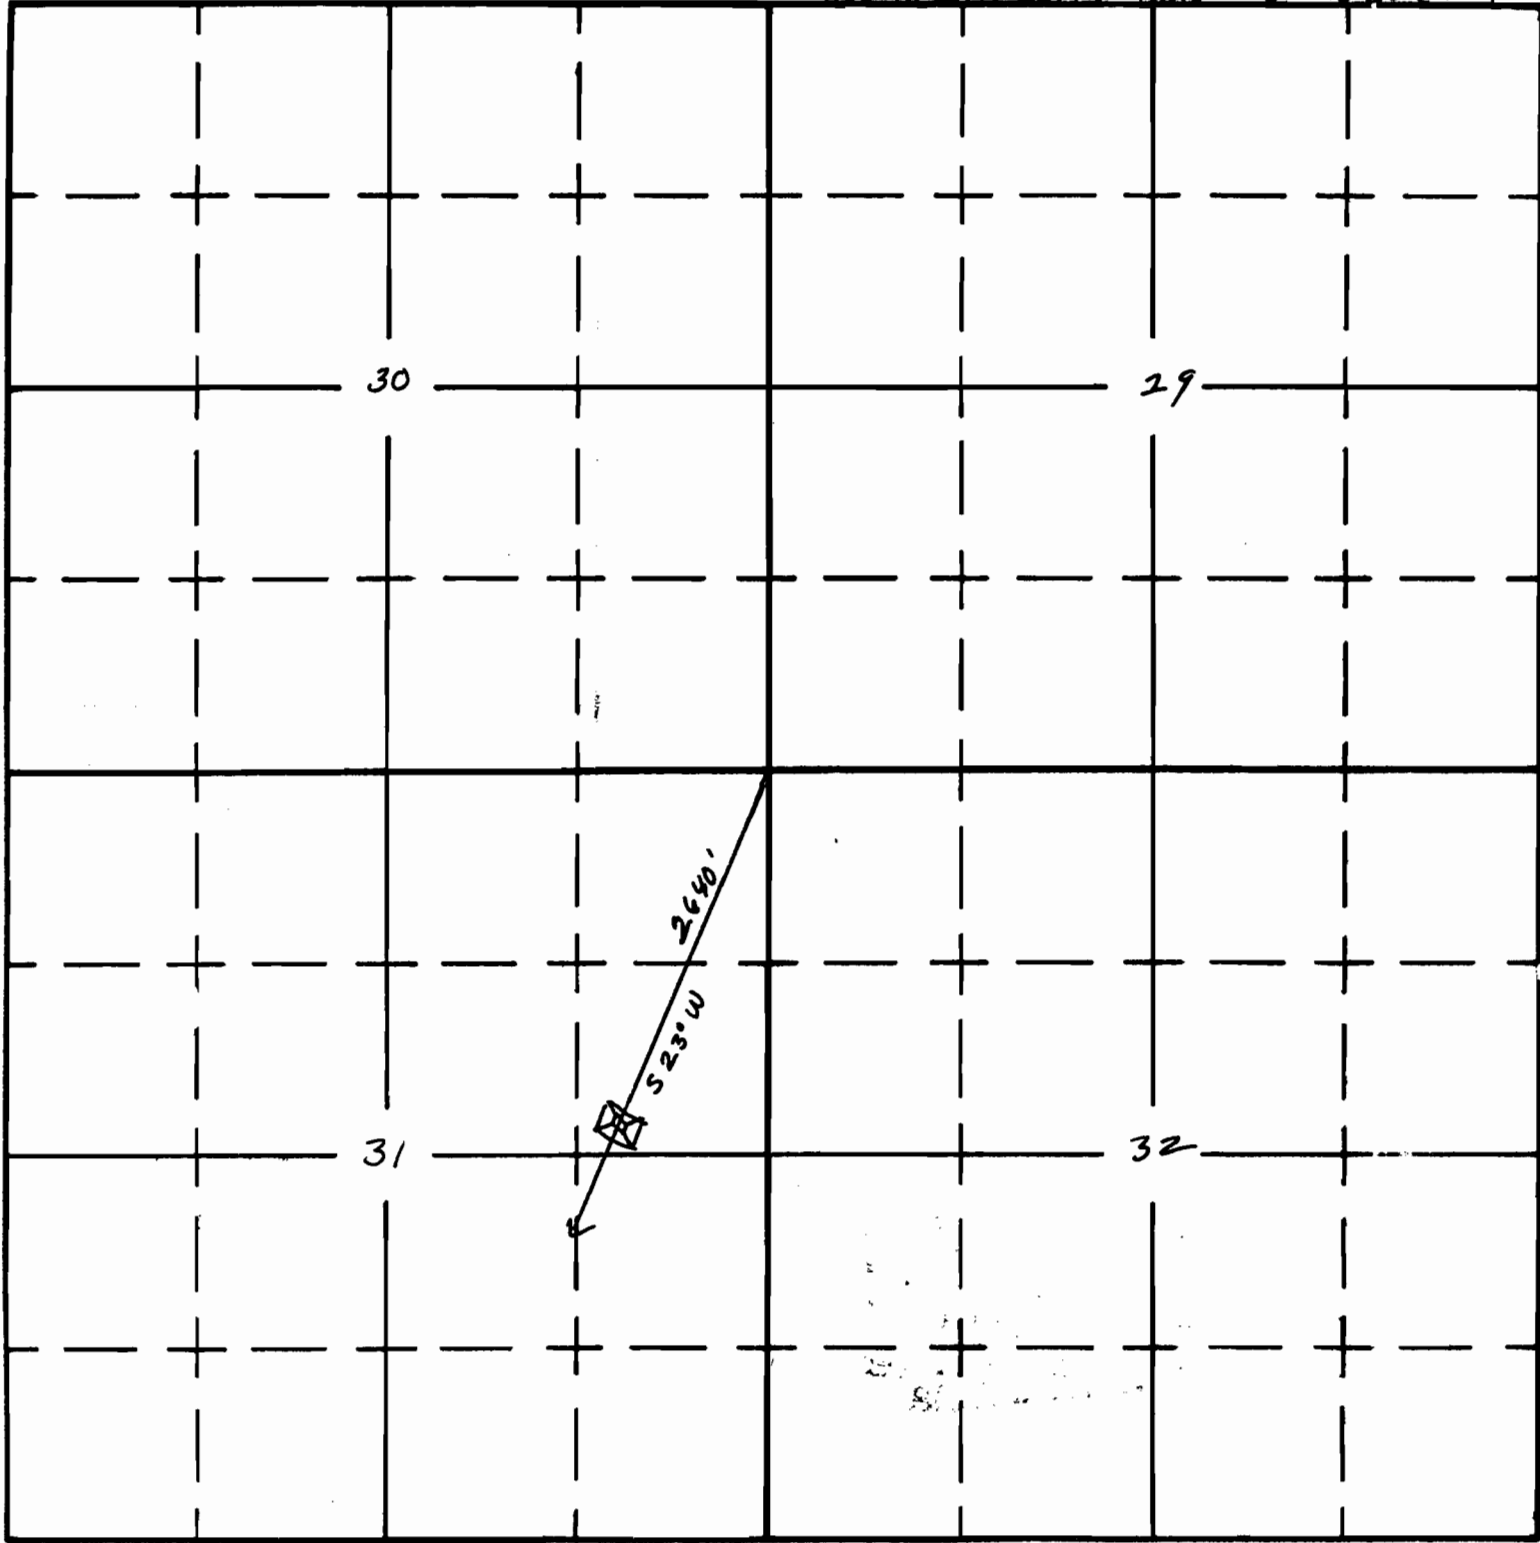

South

APPLICATION No. R. 36236
PERMIT No. R. 4083