

UNITED STATES
DEPARTMENT OF THE INTERIOR
BUREAU OF LAND MANAGEMENT


SECTION 4

Oregon State Water Filings

NW 1/4 SE 1/4

TOWNSHIP 33S, RANGE 23E, W. M.

Tied-in with aerial photos & O.S.H.D. Quad Maps

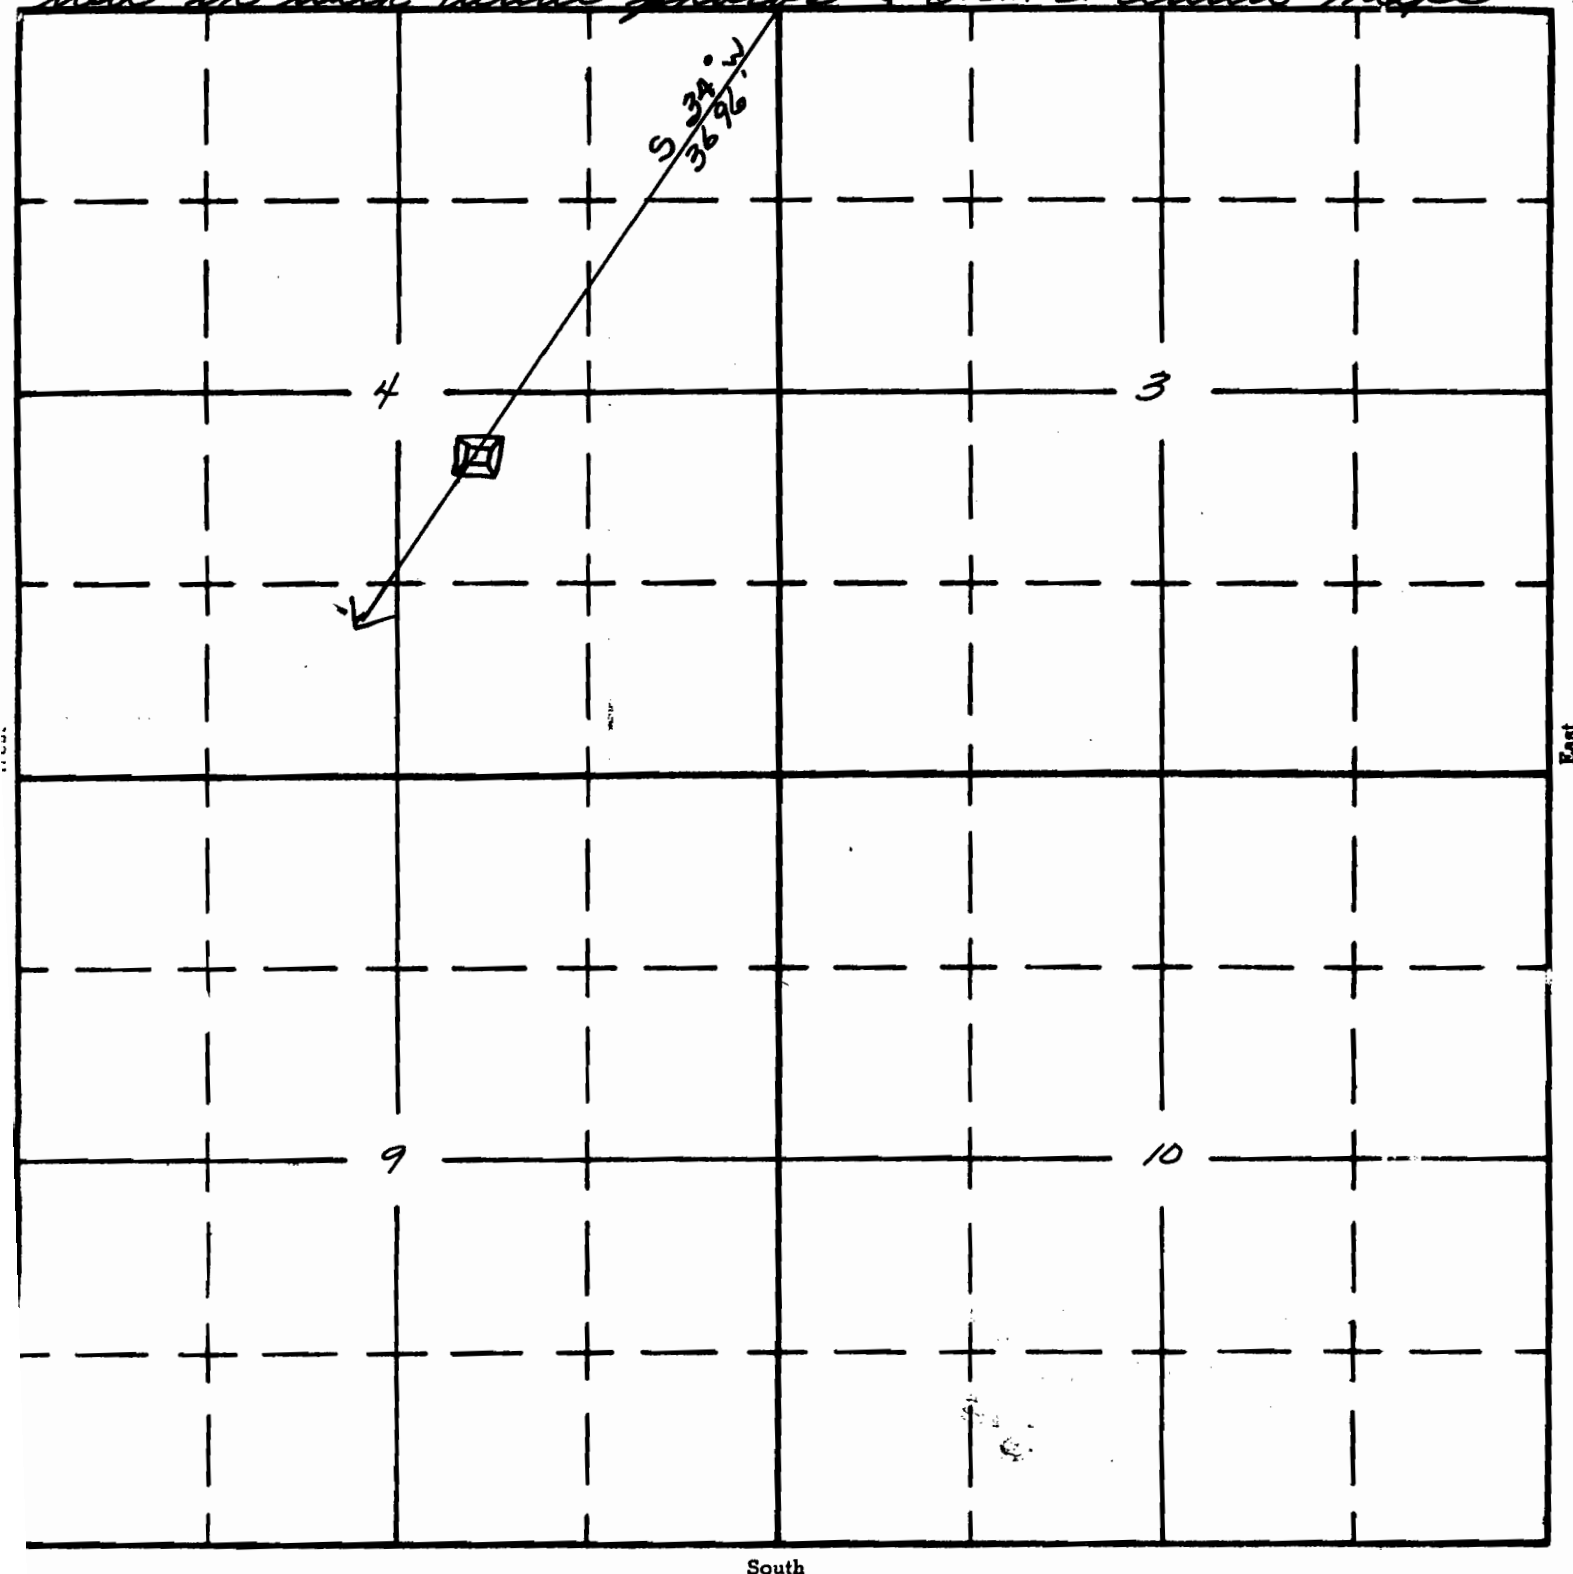

APPLICATION No. R-36263

PERMIT No. R-3589