

UNITED STATES
DEPARTMENT OF THE INTERIOR
BUREAU OF LAND MANAGEMENT


SECTION
29

Oregon State Water Filings

NW 1/4 NW 1/4

TOWNSHIP 31 S., RANGE 25 E., W. M.

Guided in with aerial photos; O.S.H.D. Quad Maps

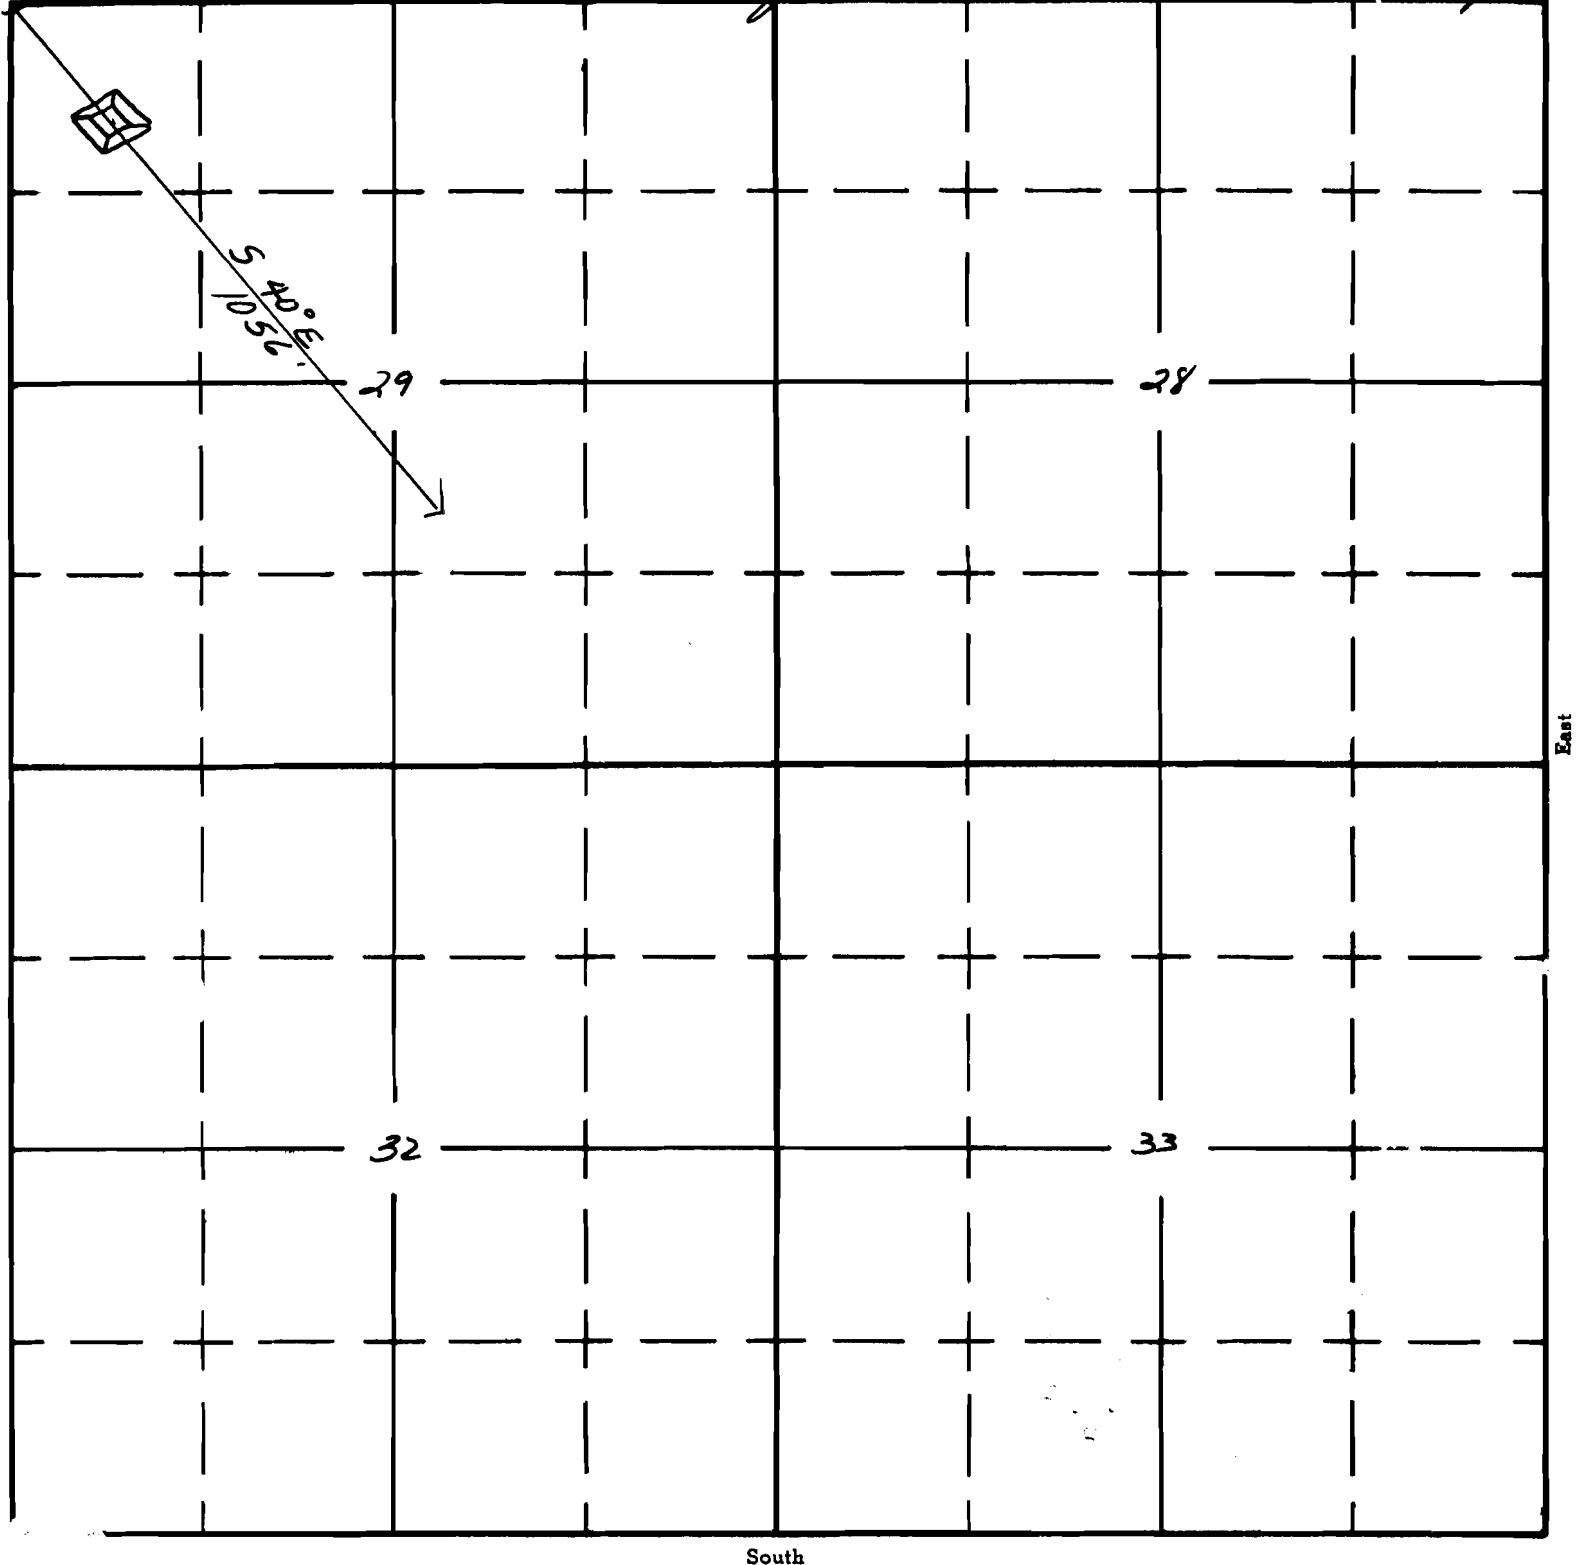

APPLICATION No. R-36265

PERMIT No. R-3770