


15

$ne^{1/4}$ $W^{1/4}$

TOWNSHIP 31 S, RANGE 26 E, W. M.

TIED-IN WITH AERIAL photos ^{North} AND D.S.H.D. QUAD MAPS

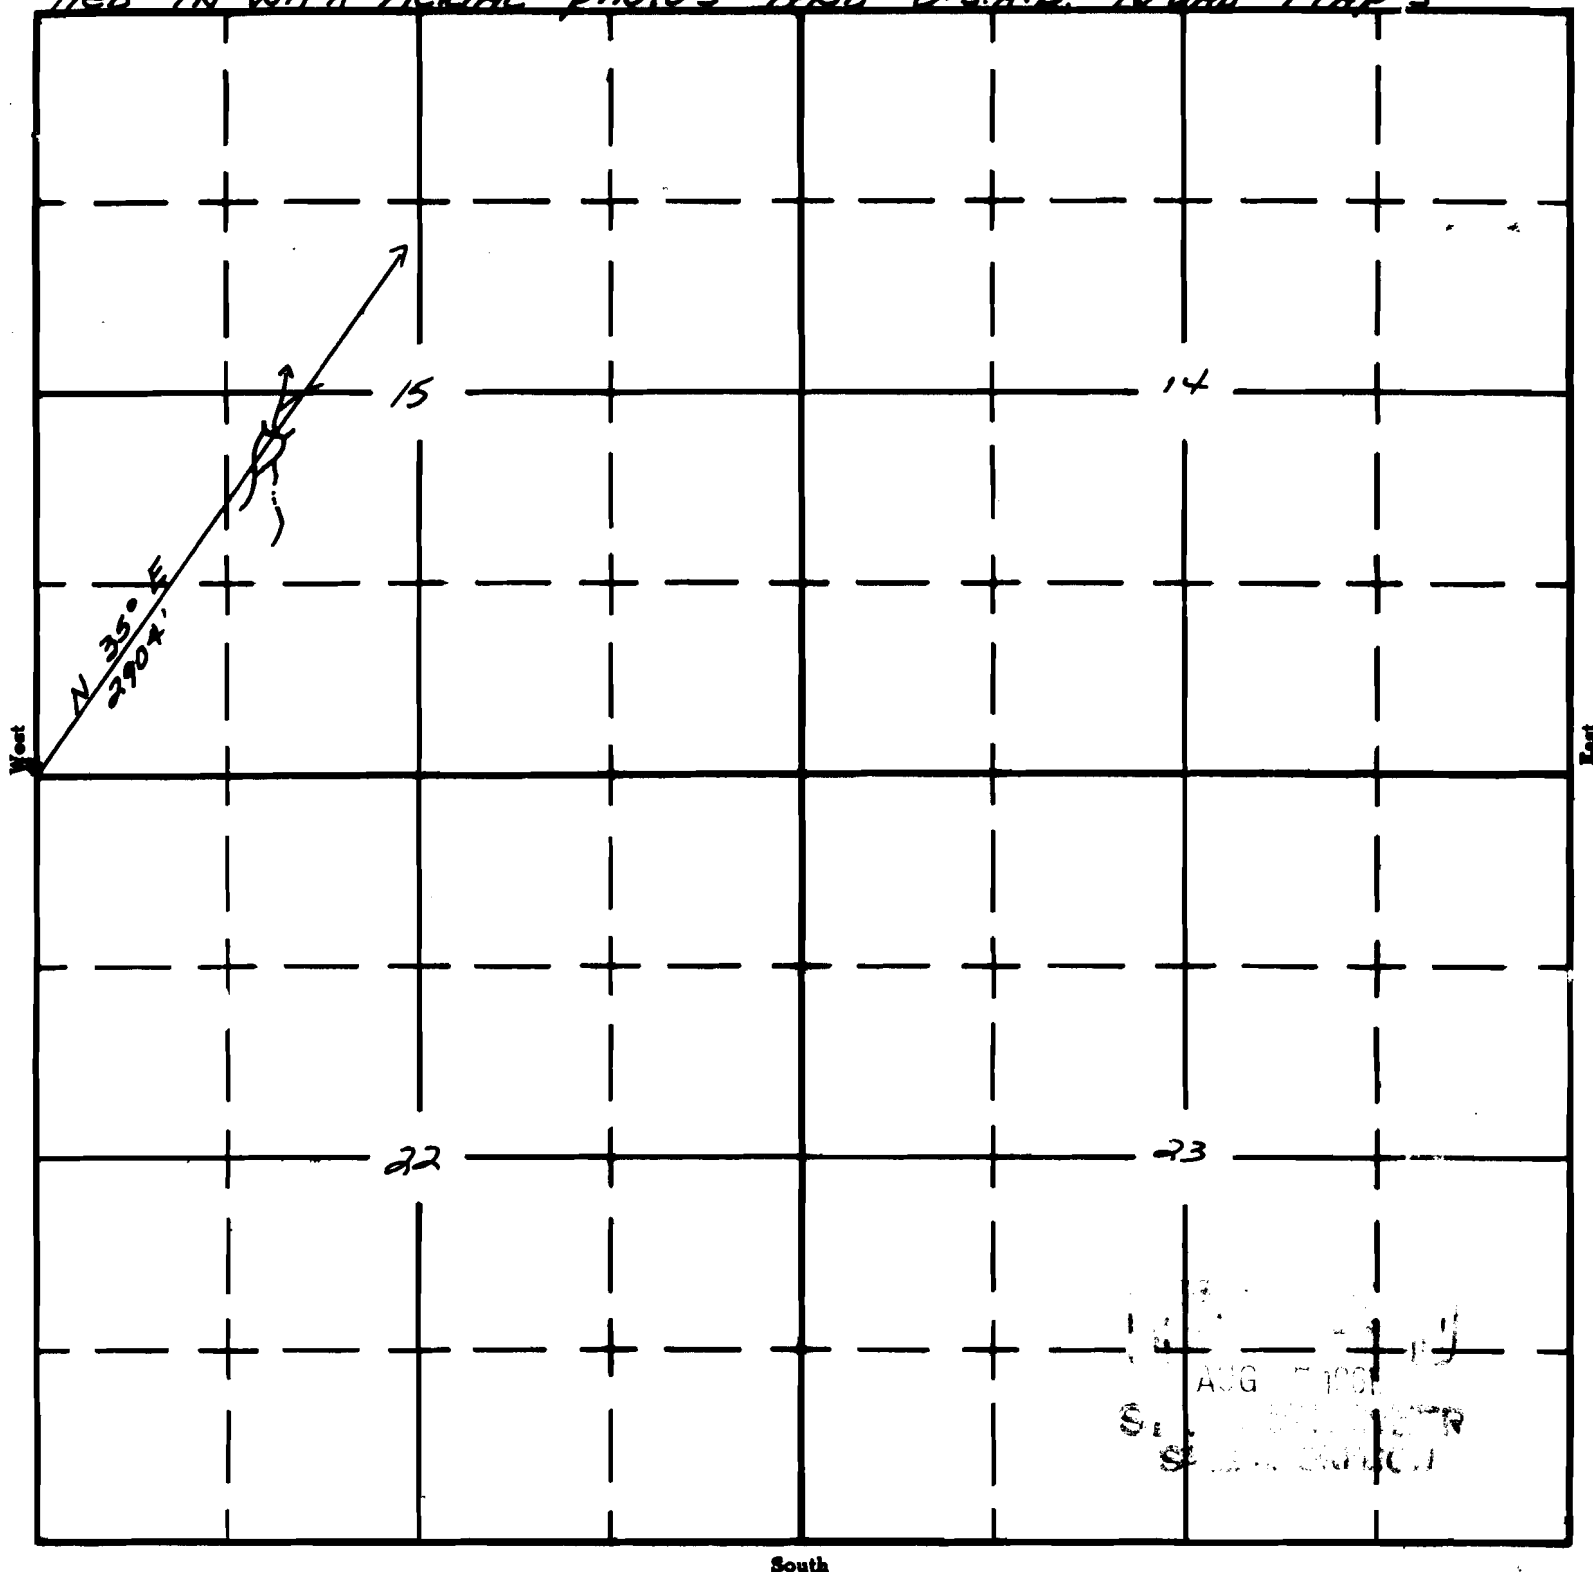

South

APPLICATION No. *A 36277*

PERMIT No. **R-3777**