

Form AI-187
March 1961

UNITED STATES
DEPARTMENT OF THE INTERIOR
BUREAU OF LAND MANAGEMENT

SECTION


11

SW¹/₄ SW¹/₄

Oregon State Water Filings

TOWNSHIP 32S, RANGE 23E, W. M.

North *Tied in with aerial photo and OSMD Quad maps.*

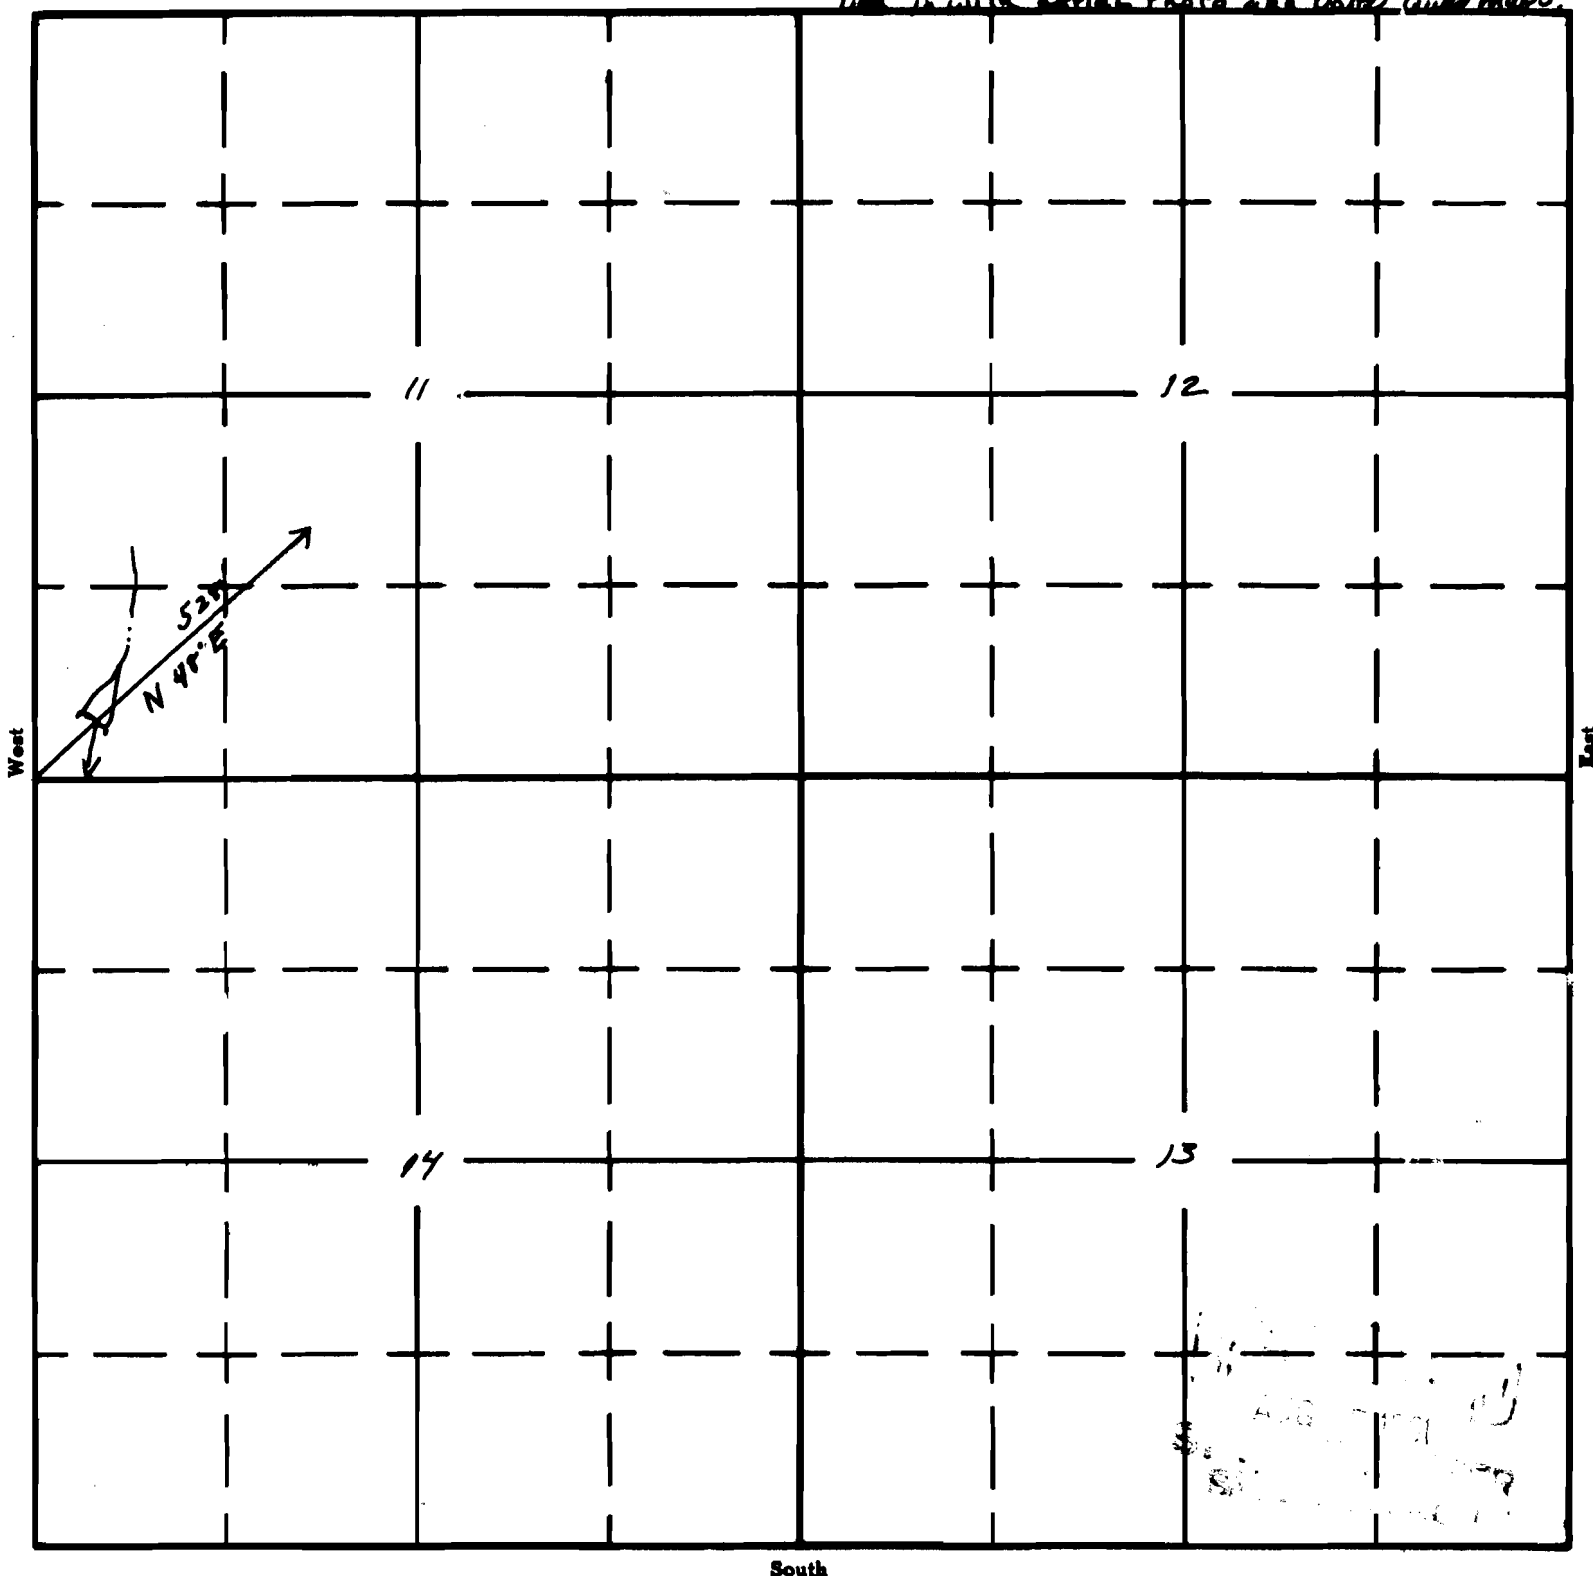

South

APPLICATION No. R-36286
PERMIT No. R-3594