

Form AI-187
March 1961

UNITED STATES
DEPARTMENT OF THE INTERIOR
BUREAU OF LAND MANAGEMENT

SECTION


12

SE 1/4 SE 1/4

Oregon State Water Filings

TOWNSHIP 32S, RANGE 23E, W. M.

North *Tied in with aerial Photo and USAR Quad Map.*

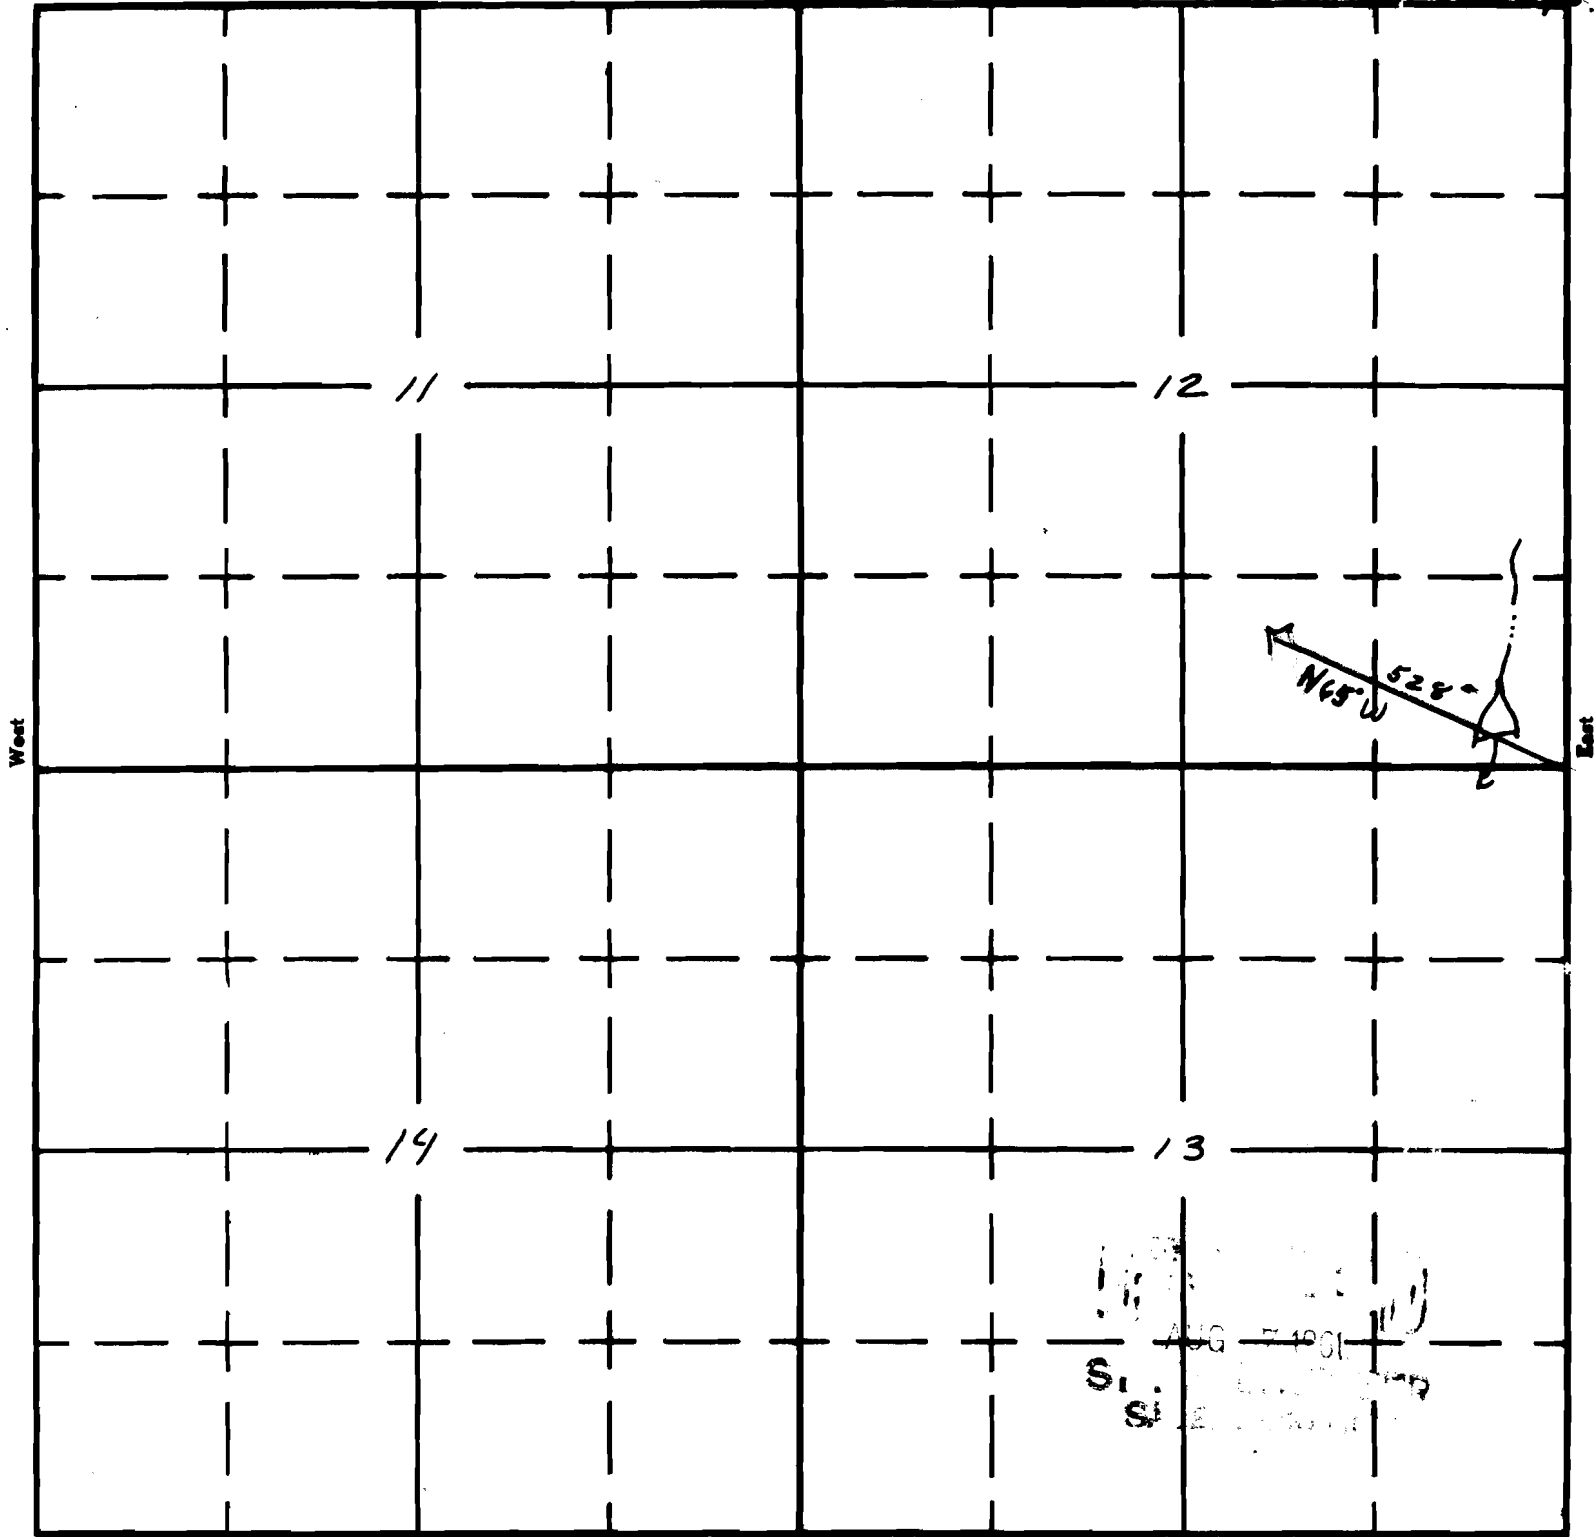

AUG 7 1961
S. L. ...
S. L. ...

APPLICATION No. R-36287
PERMIT No. R-3595