

UNITED STATES
DEPARTMENT OF THE INTERIOR
BUREAU OF LAND MANAGEMENT

SECTION


12

NW 1/4 SE 1/4

Oregon State Water Filings

TOWNSHIP 31S, RANGE 23E, W. M.

North Tied in with aerial Photo and OSRD Grid Maps

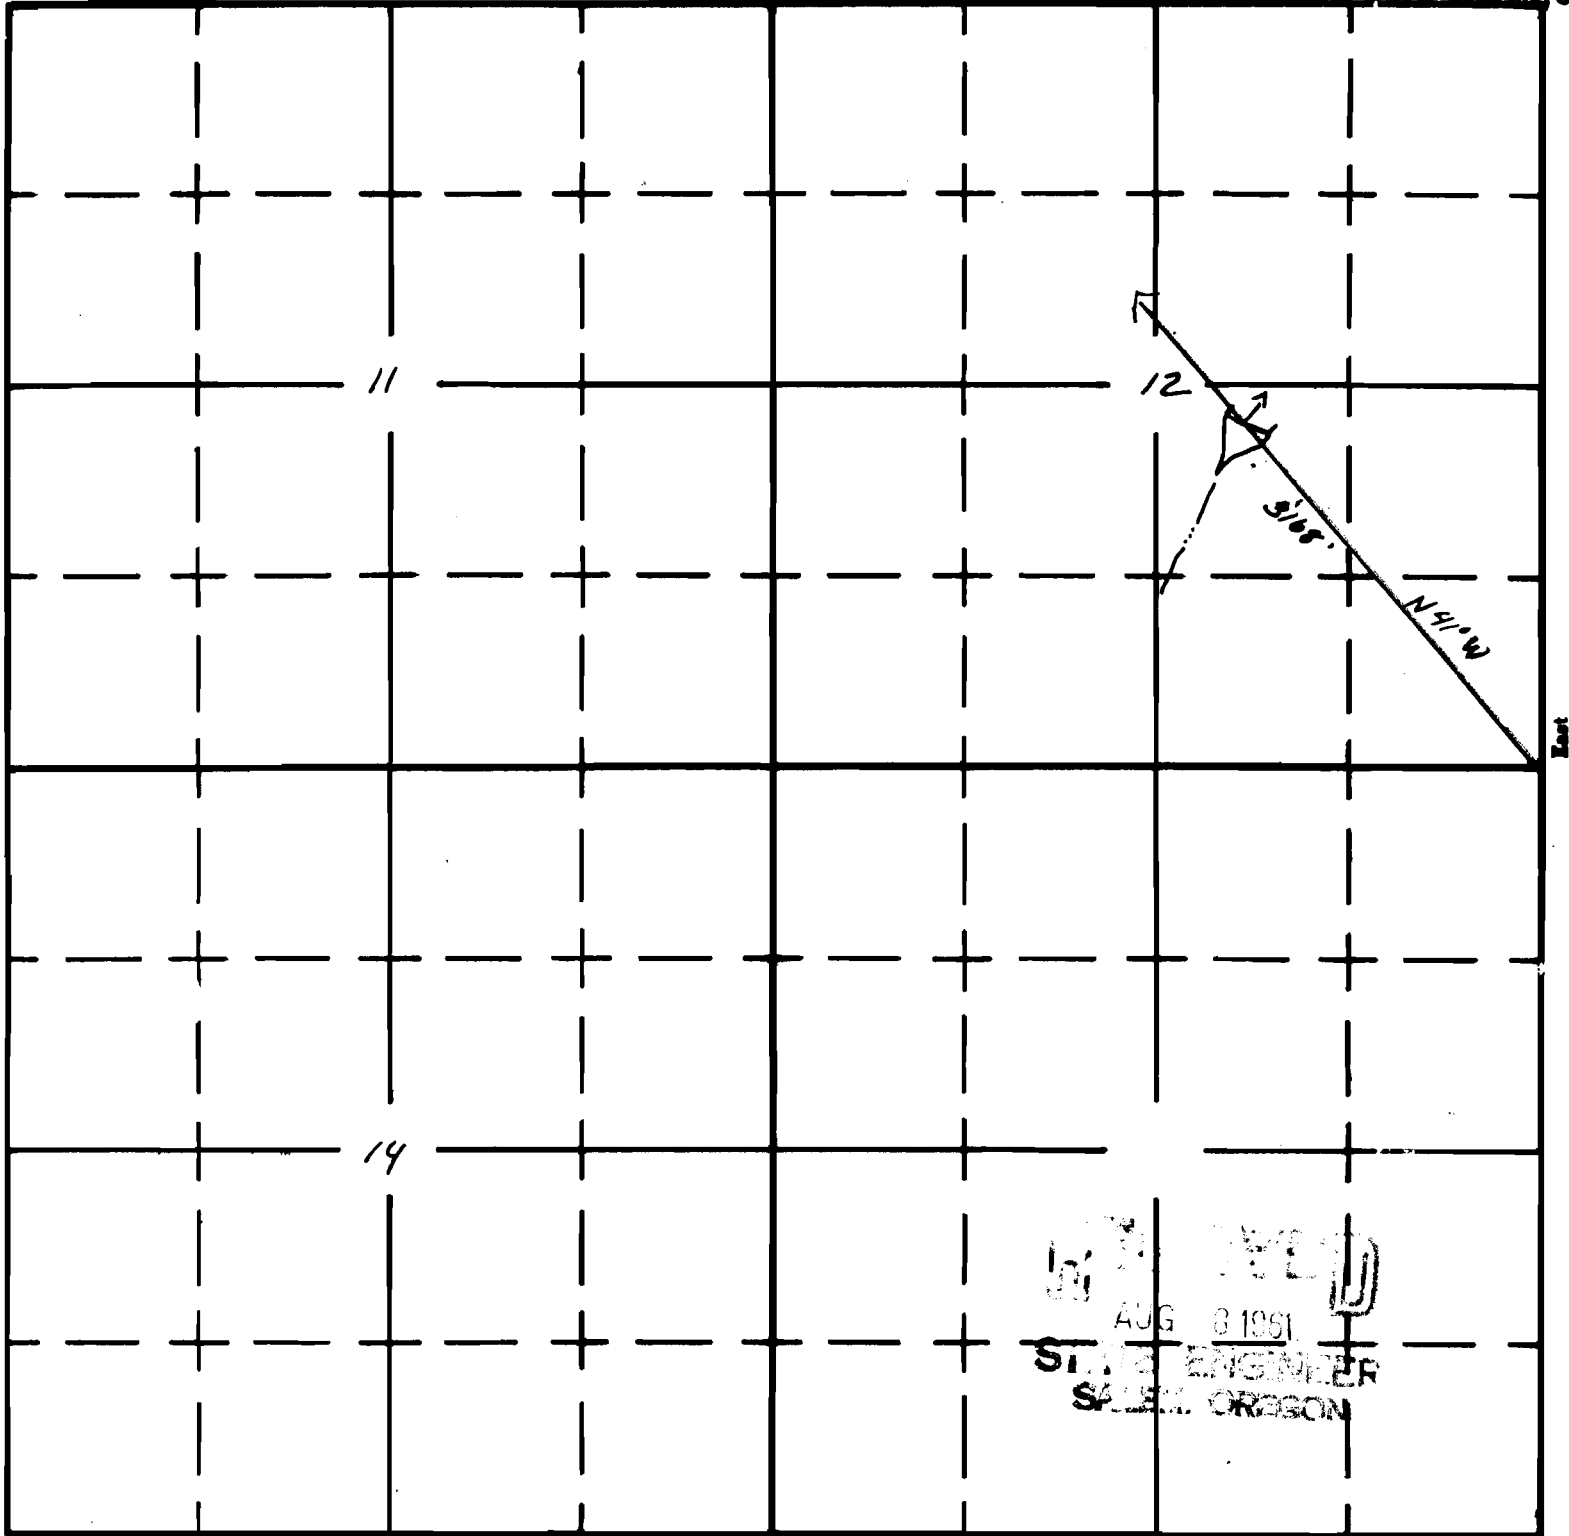

South

APPLICATION No. R-36347

PERMIT No. R-3633