

Form AI-187
March 1961

UNITED STATES
DEPARTMENT OF THE INTERIOR
BUREAU OF LAND MANAGEMENT

SECTION


24

NE 1/4 SE 1/4

Oregon State Water Filings

TOWNSHIP 35S, RANGE 21E, W. M.

North Tied in with aerial photo and OSMD Quad Maps.

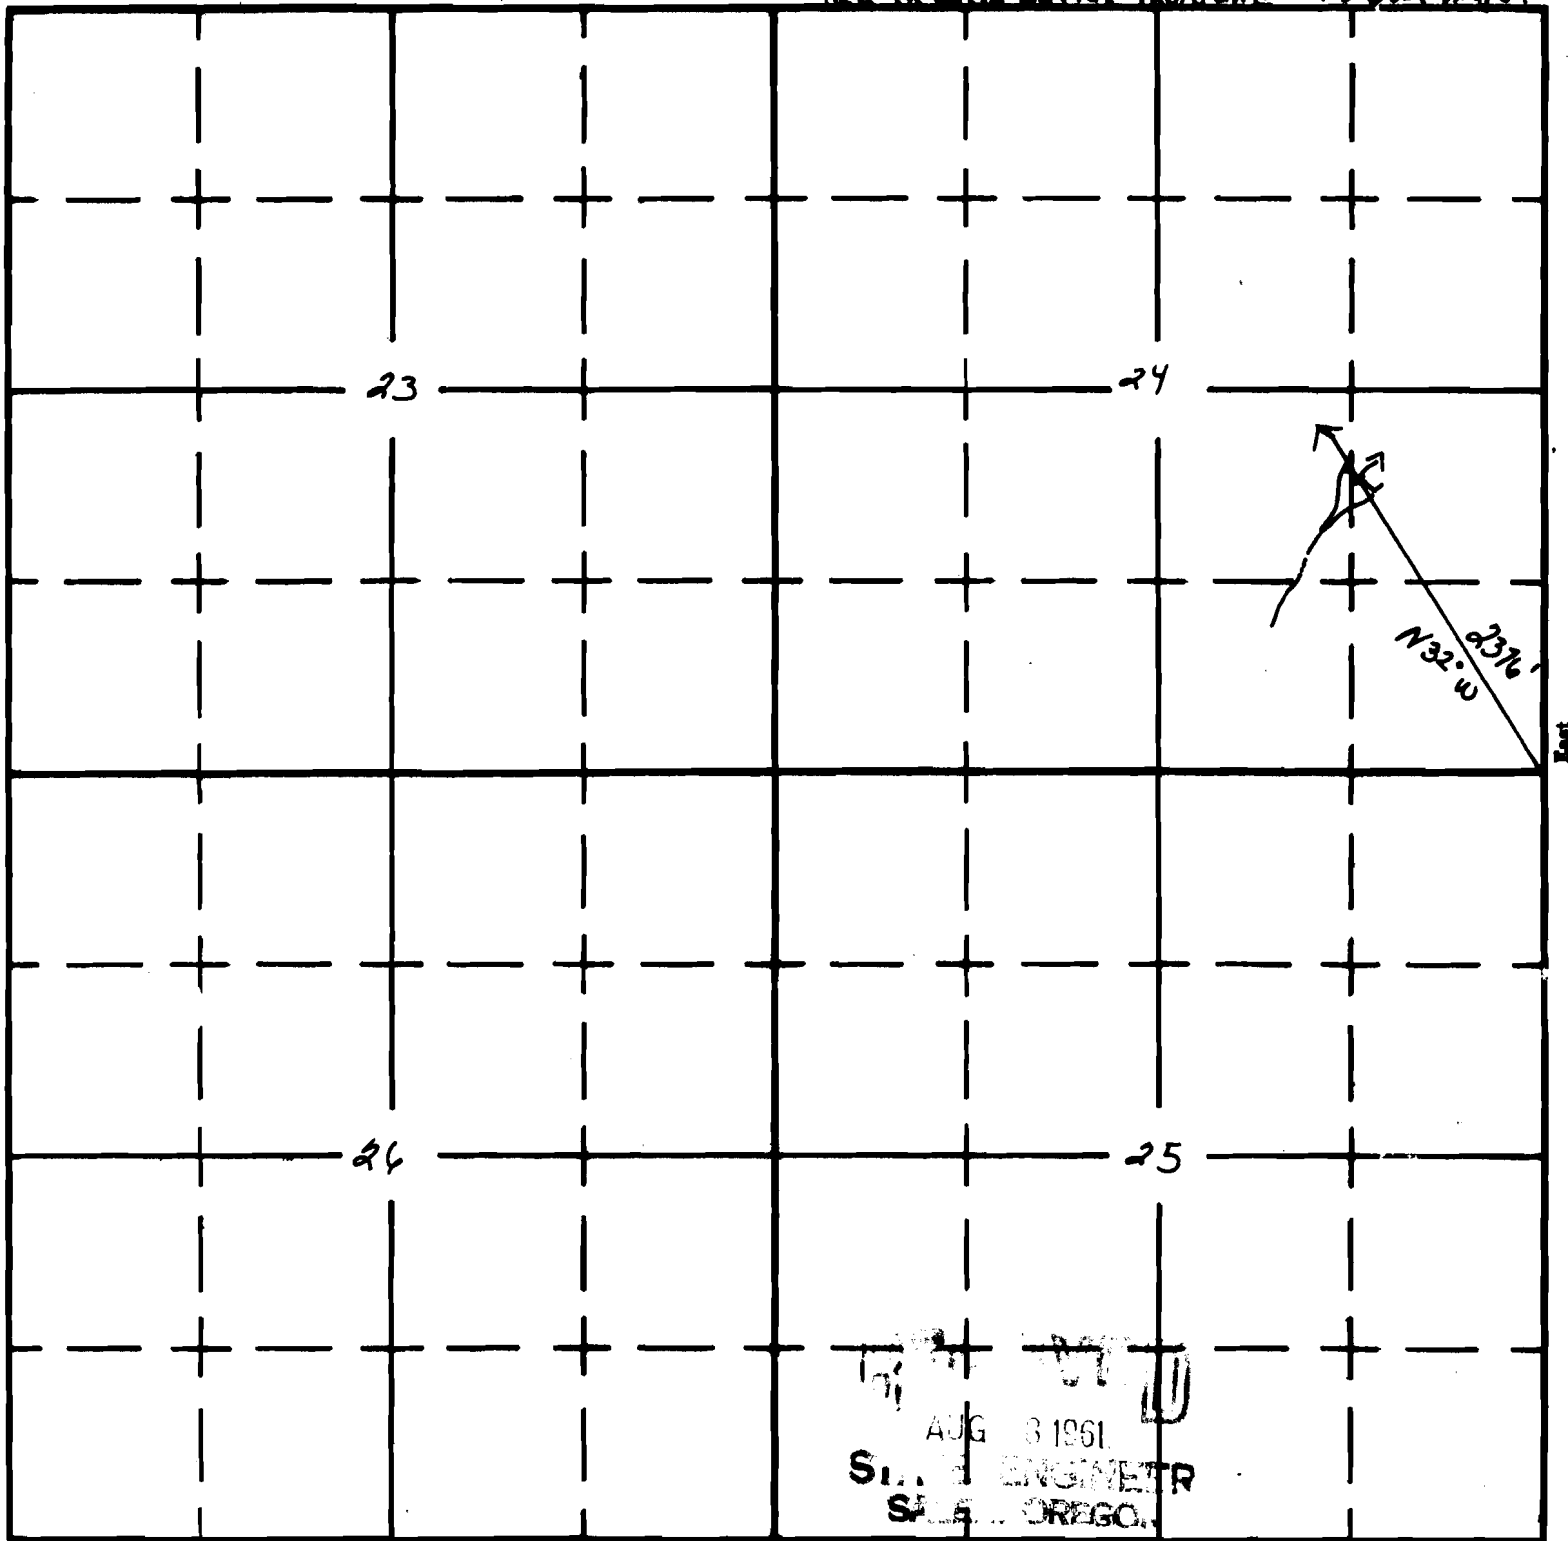

APPLICATION No. R-36441
PERMIT No. R-3639