

Form A1-187
March 1961


UNITED STATES
DEPARTMENT OF THE INTERIOR
BUREAU OF LAND MANAGEMENT

R-3642
66929

SECTION 6
NE 1/4 NE 1/4

Oregon State Water Filings

TOWNSHIP 35S, RANGE 23E, W. M.

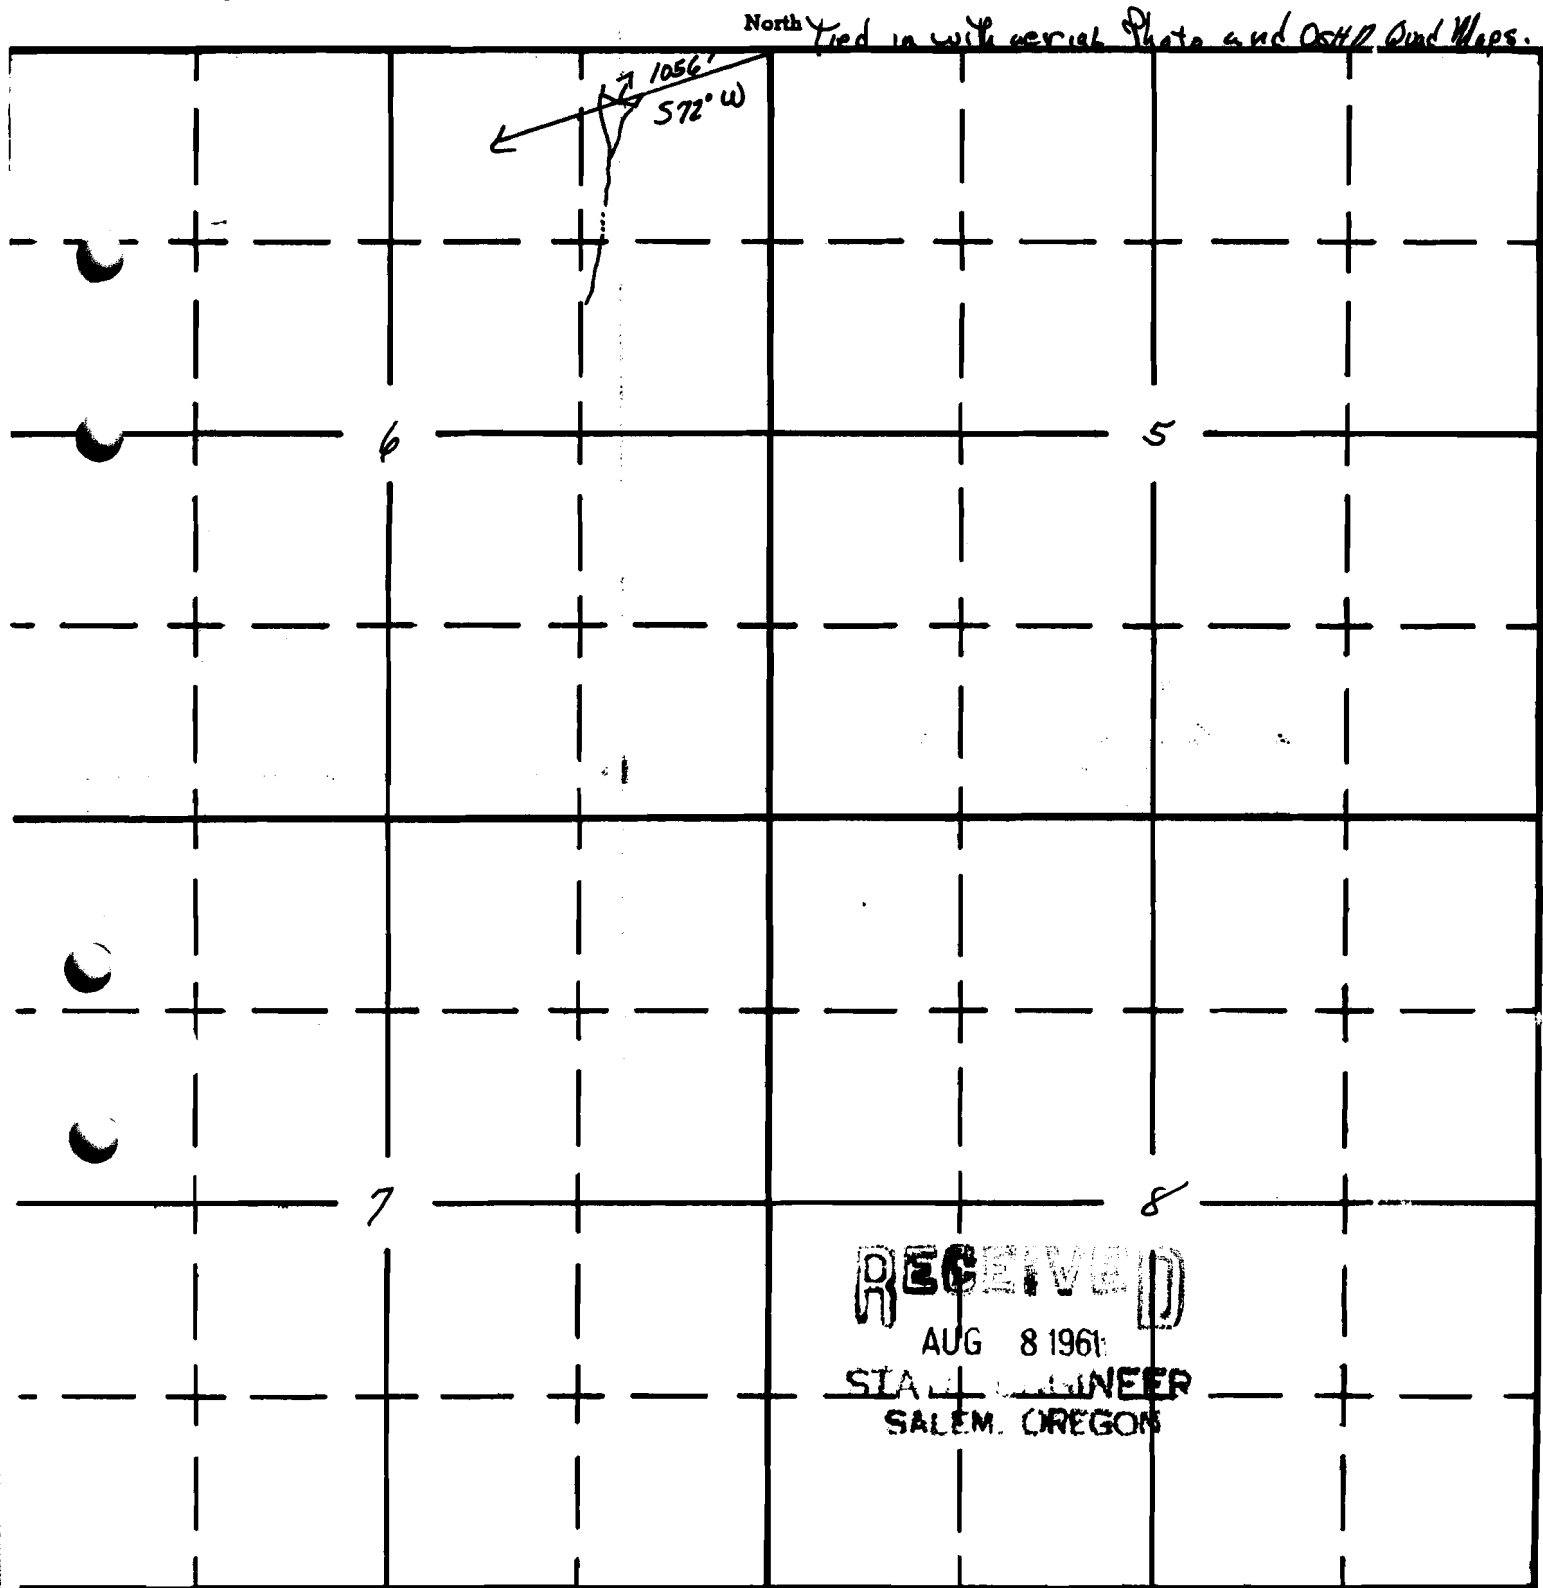

South

APPLICATION No. R-36456
PERMIT No. R-3642