

Form AI-187
March 1961

UNITED STATES
DEPARTMENT OF THE INTERIOR
BUREAU OF LAND MANAGEMENT

SECTION 11


Oregon State Water Filings

SW 1/4 SW 1/4

TOWNSHIP 35S, RANGE 23E, W. M.

RECEIVED
STATE WATER
ADMINISTRATION

North

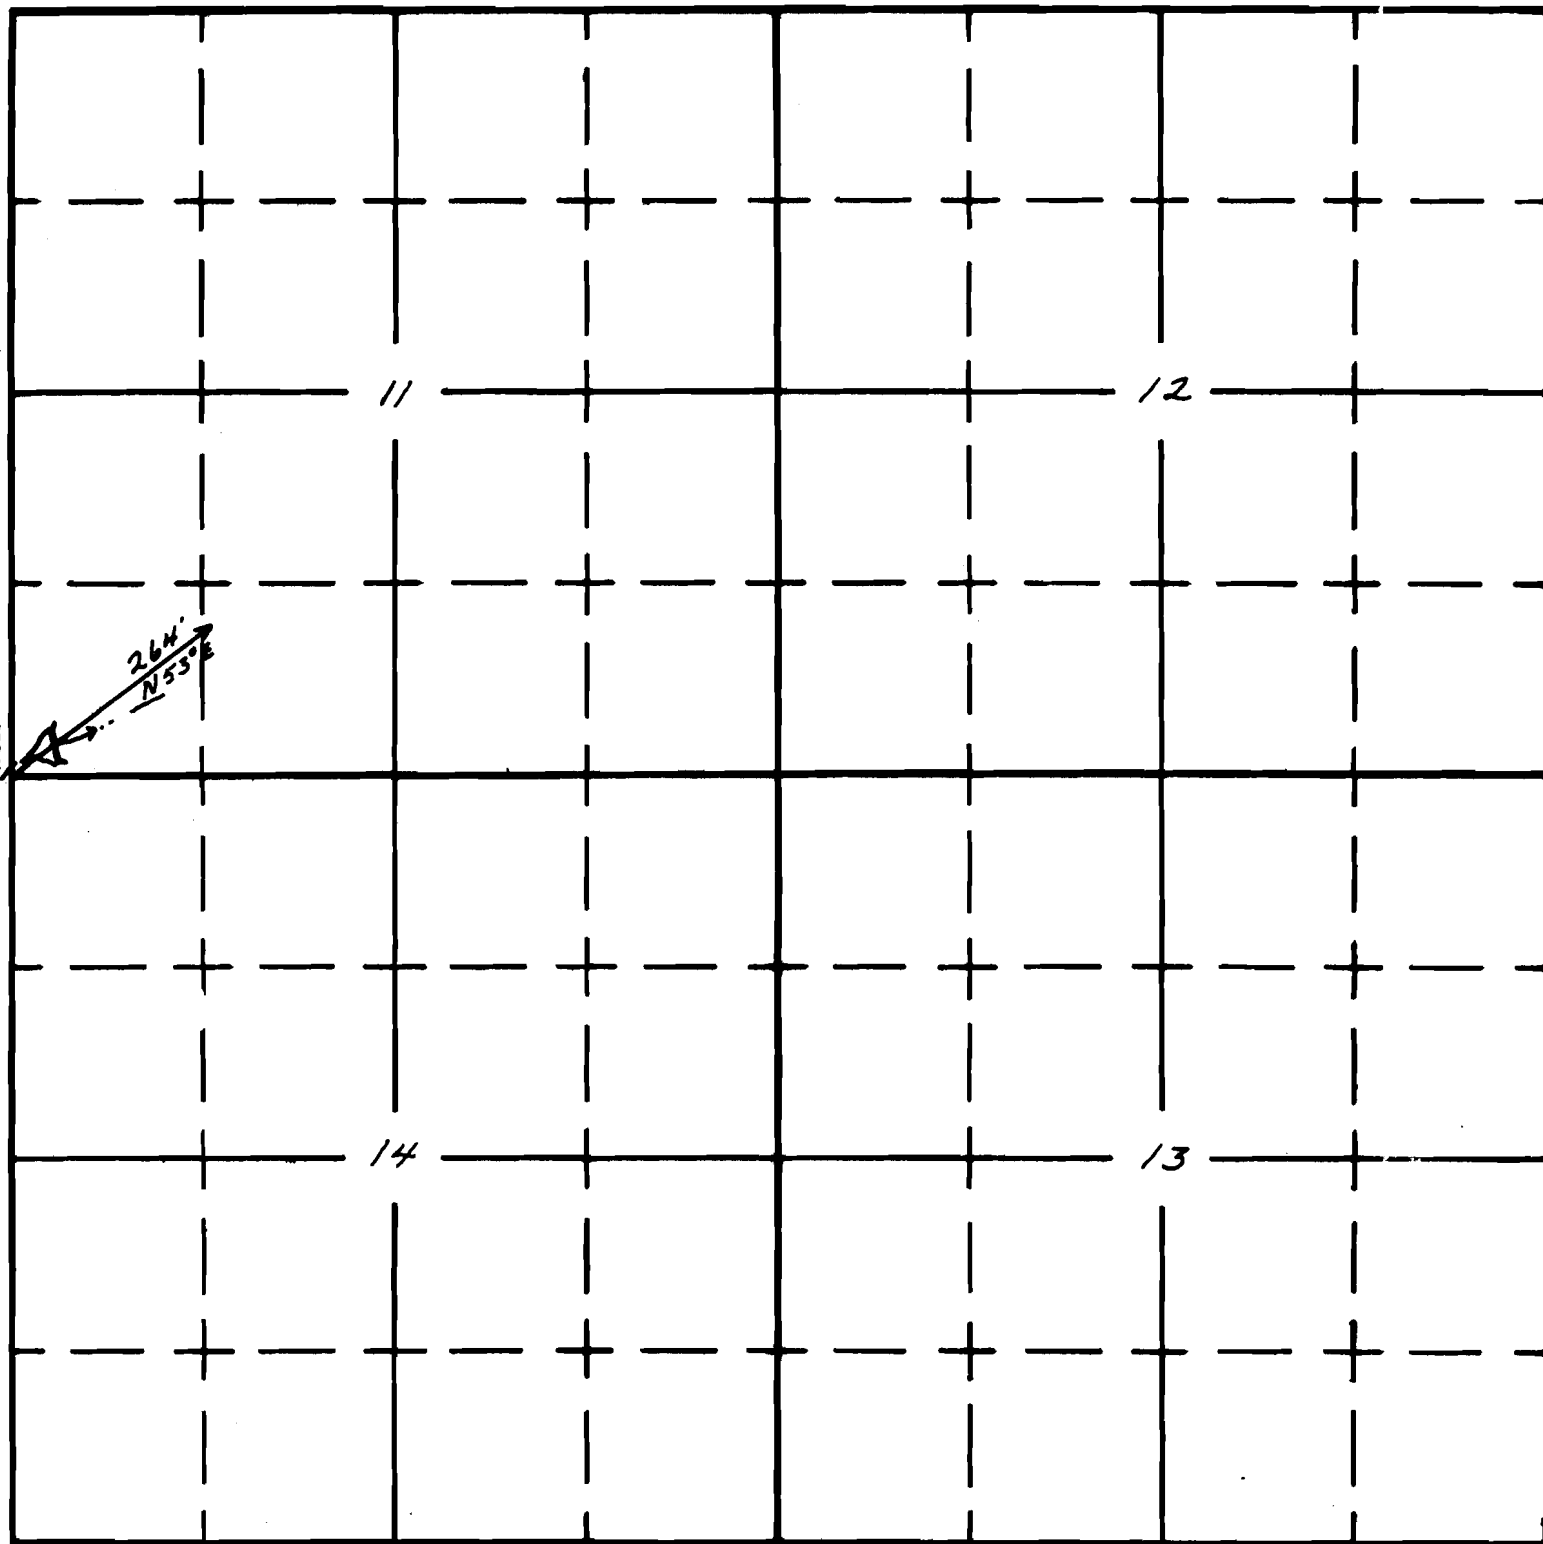

Fox Res.
0-1-640

South

APPLICATION No. R-36464
PERMIT No. R-4105