


UNITED STATES
DEPARTMENT OF THE INTERIOR
BUREAU OF LAND MANAGEMENT

SECTION 23
SE & NW 1/4

Oregon State Water Filings

TOWNSHIP 35S, RANGE 23E, W. M.

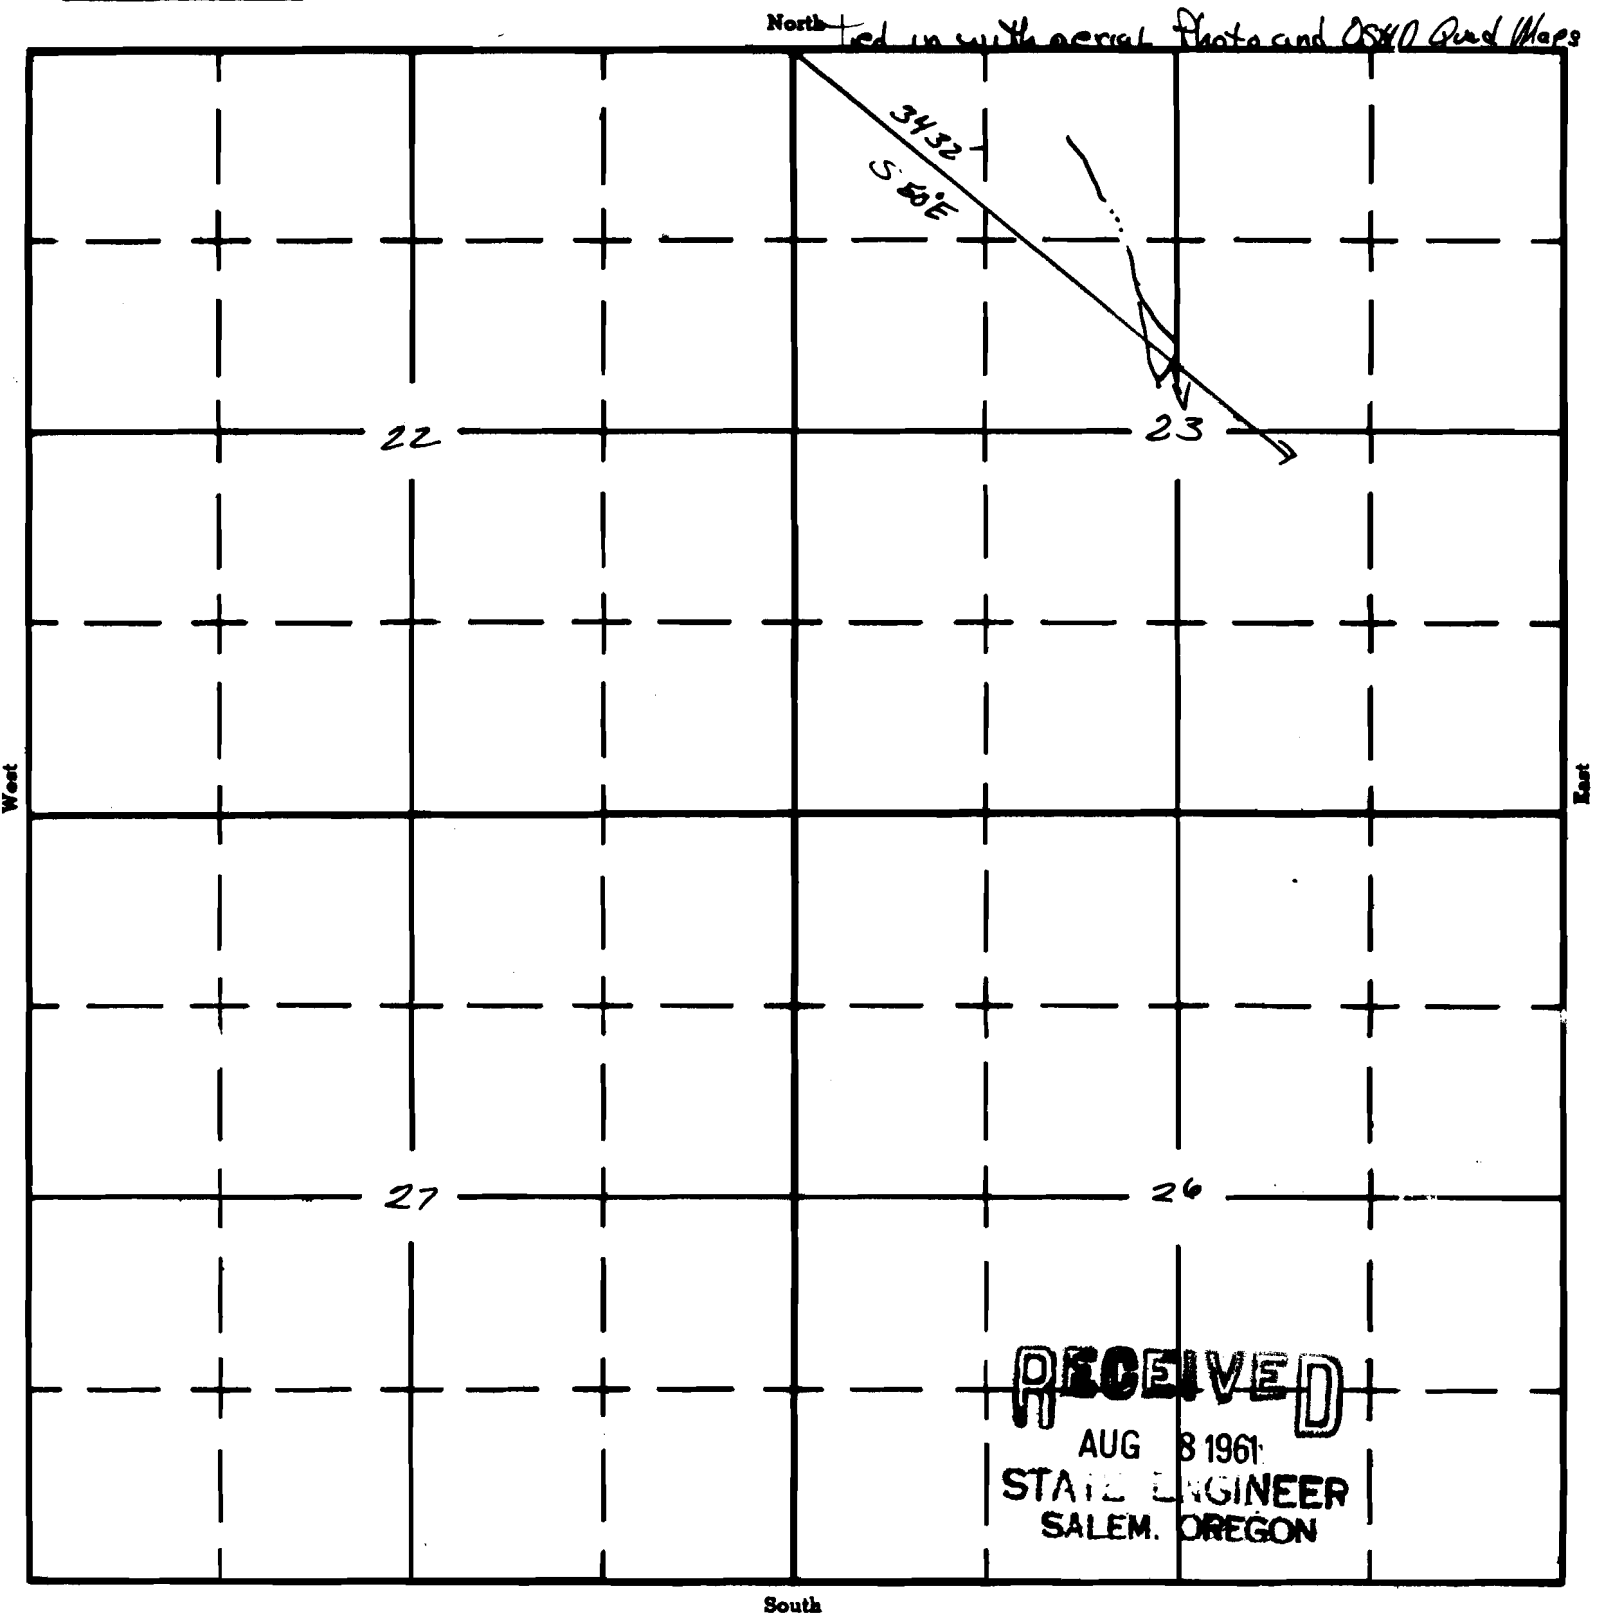

APPLICATION No. R-38467
PERMIT No. R-4108