


Form A1-187
March 1961

UNITED STATES
DEPARTMENT OF THE INTERIOR
BUREAU OF LAND MANAGEMENT

SECTION 20 **Oregon State Water Filings**

NW 1/4 NE 1/4 TOWNSHIP 38 S, RANGE 24 E, W. M.

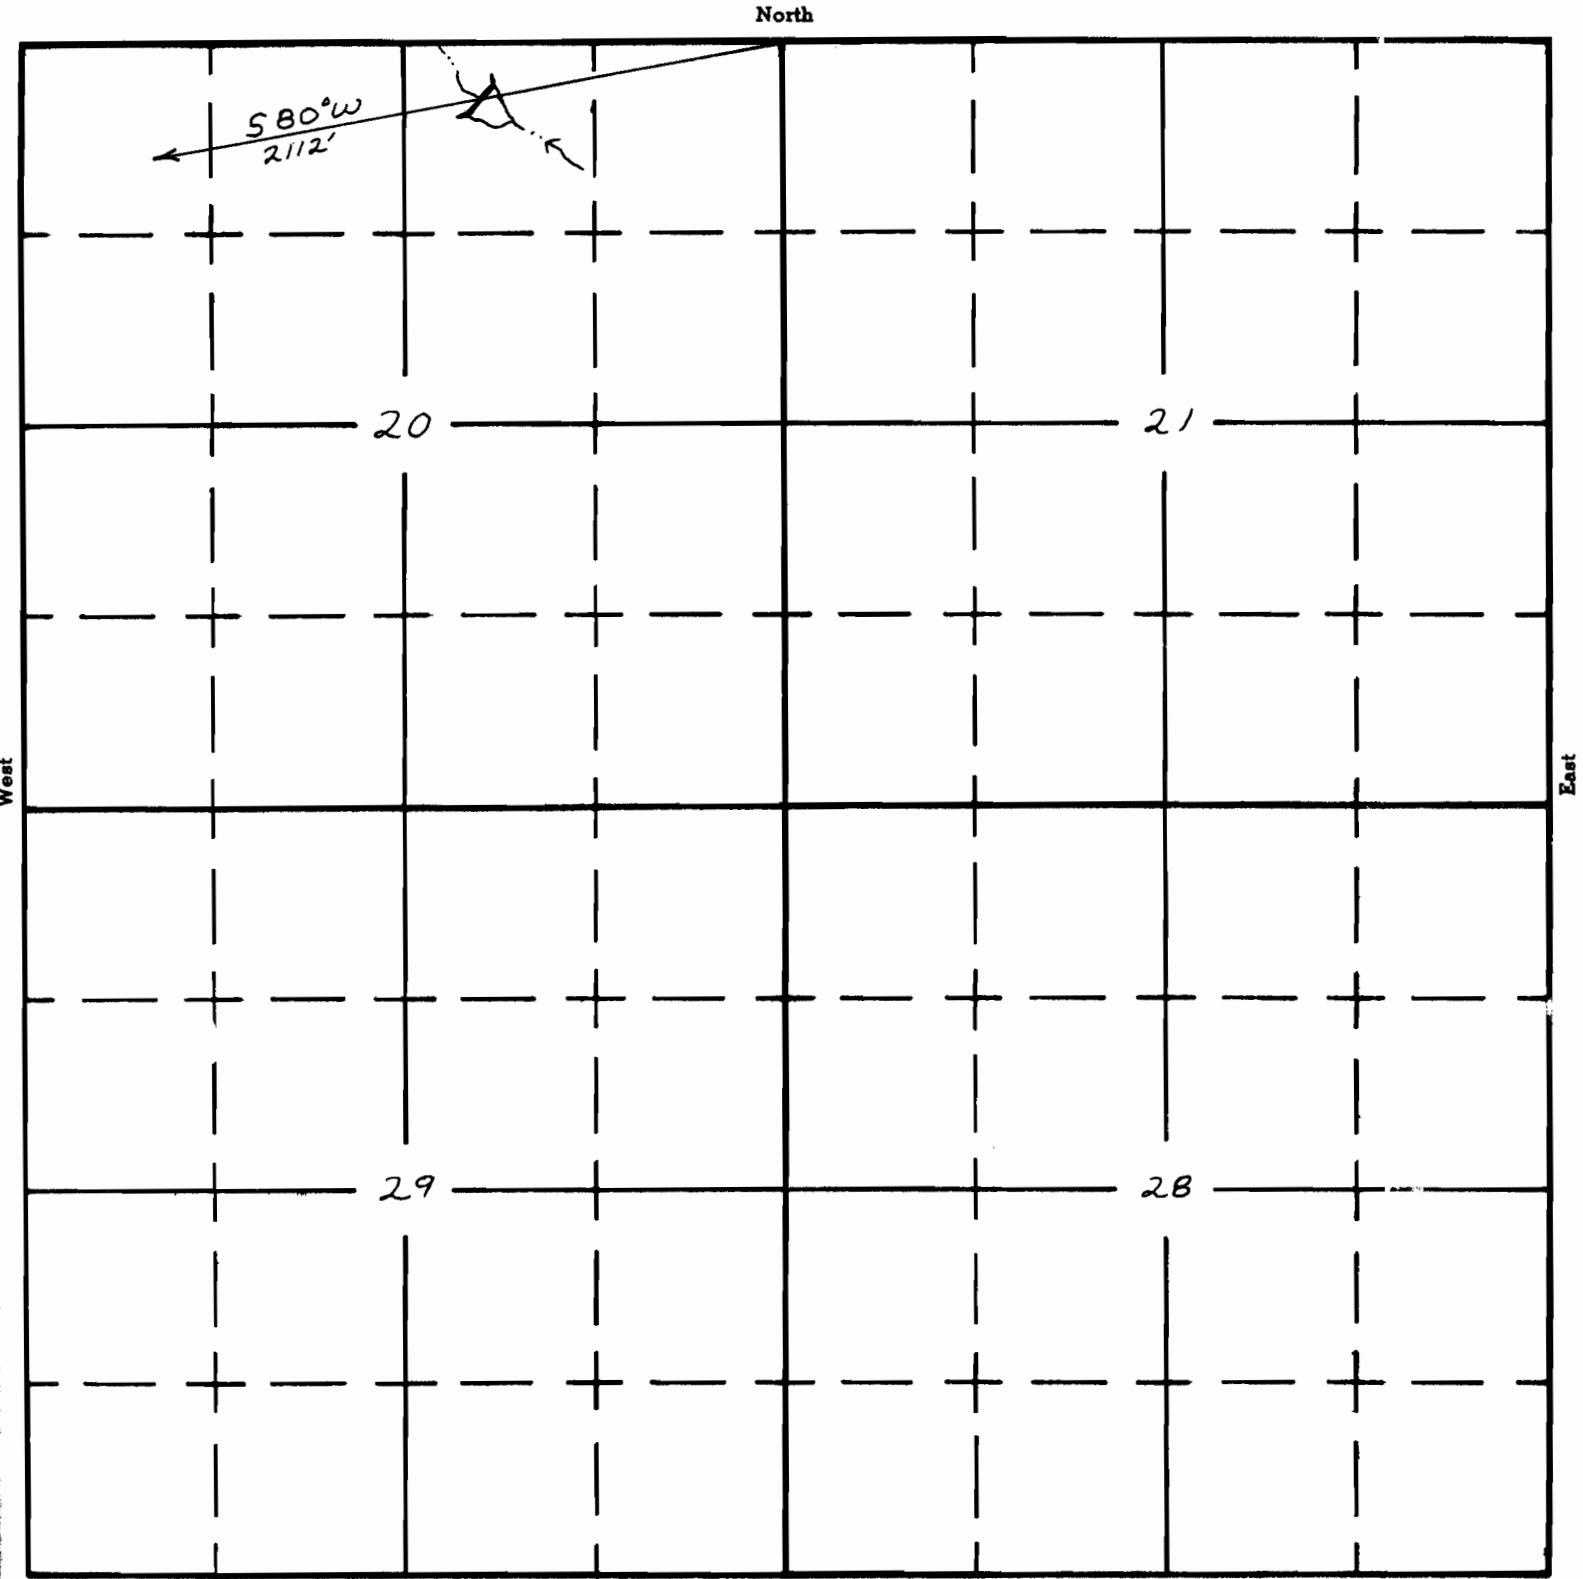

Side winder Wh.
0-1-519

APPLICATION No. R-36562
PERMIT No. R-4375