


R-6244

66935

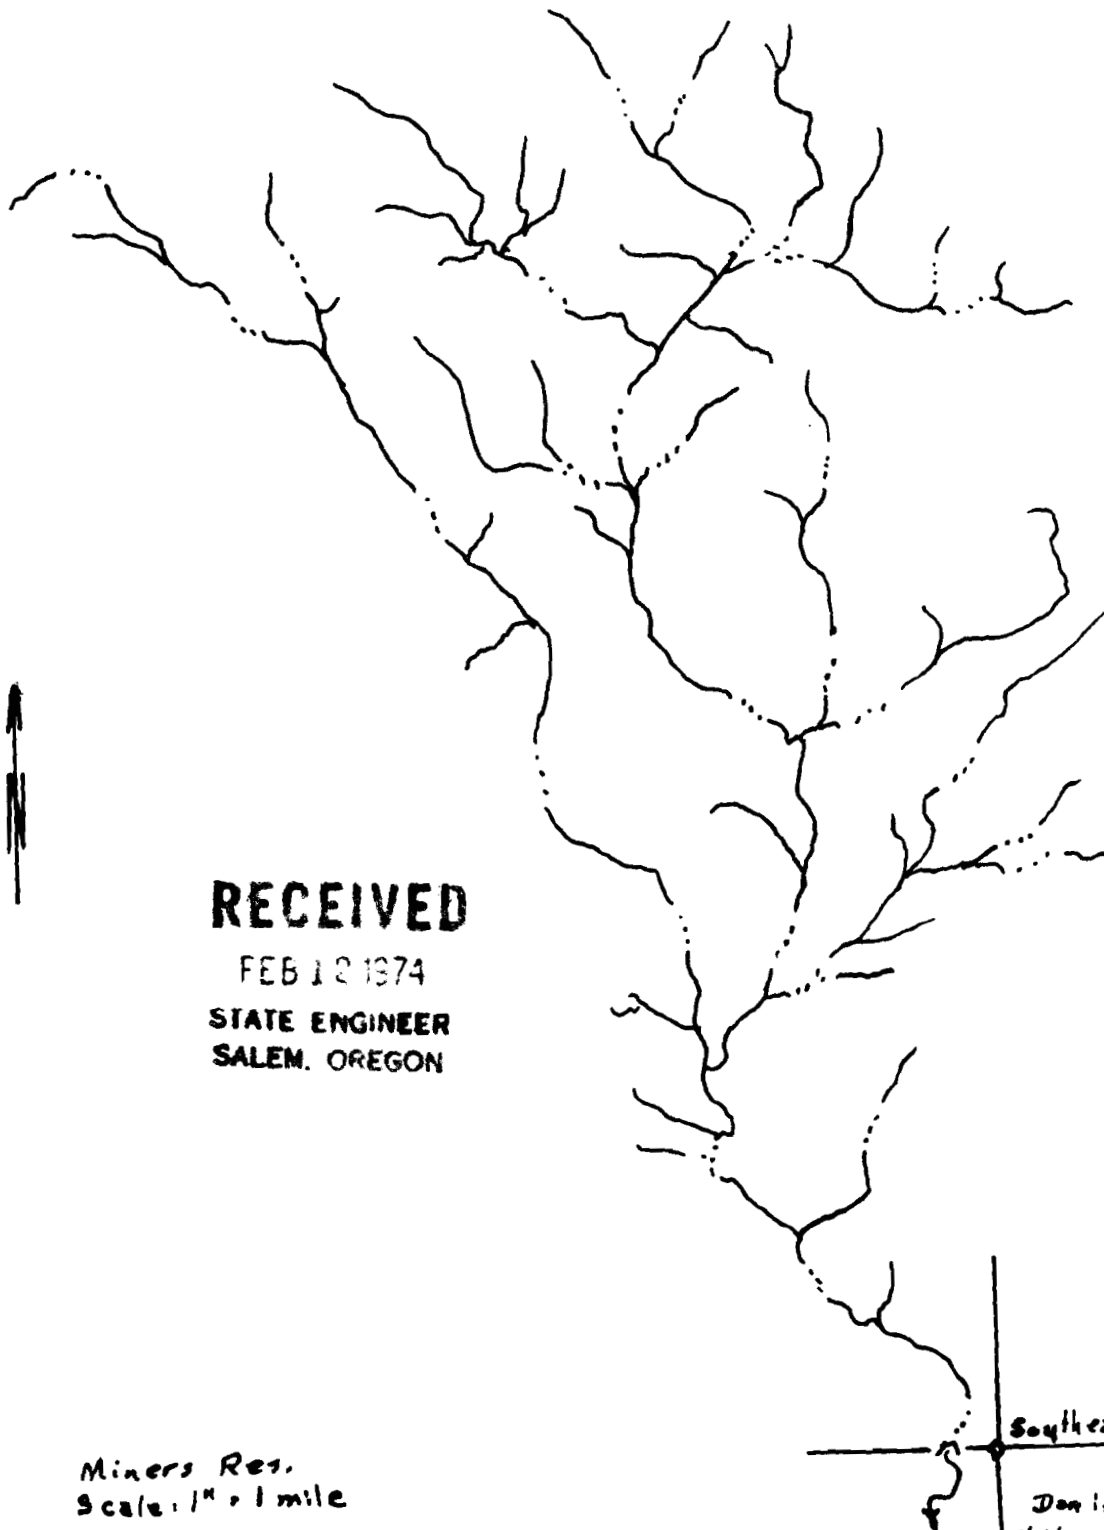

RECEIVED

FEB 12 1974

STATE ENGINEER
SALEM, OREGON

Miners Res.
Scale: 1" = 1 mile

Application
Permit No.

R-51659

R 6244

Southeast cor. Sec. 28

Don is 1265' west and
160' north of the
southeast sec. corner
of Sec. 28, T. 32S.,
R. 24E., W.M.

32-24 ✓