


APPLICATION MAP FOR FLAG PRAIRIE ALLOTMENT
scale 4" : 1 mi.

NORTH ↑

T16S R36E

APPLICATION NO. R-62094 PERMIT NO. R 9208

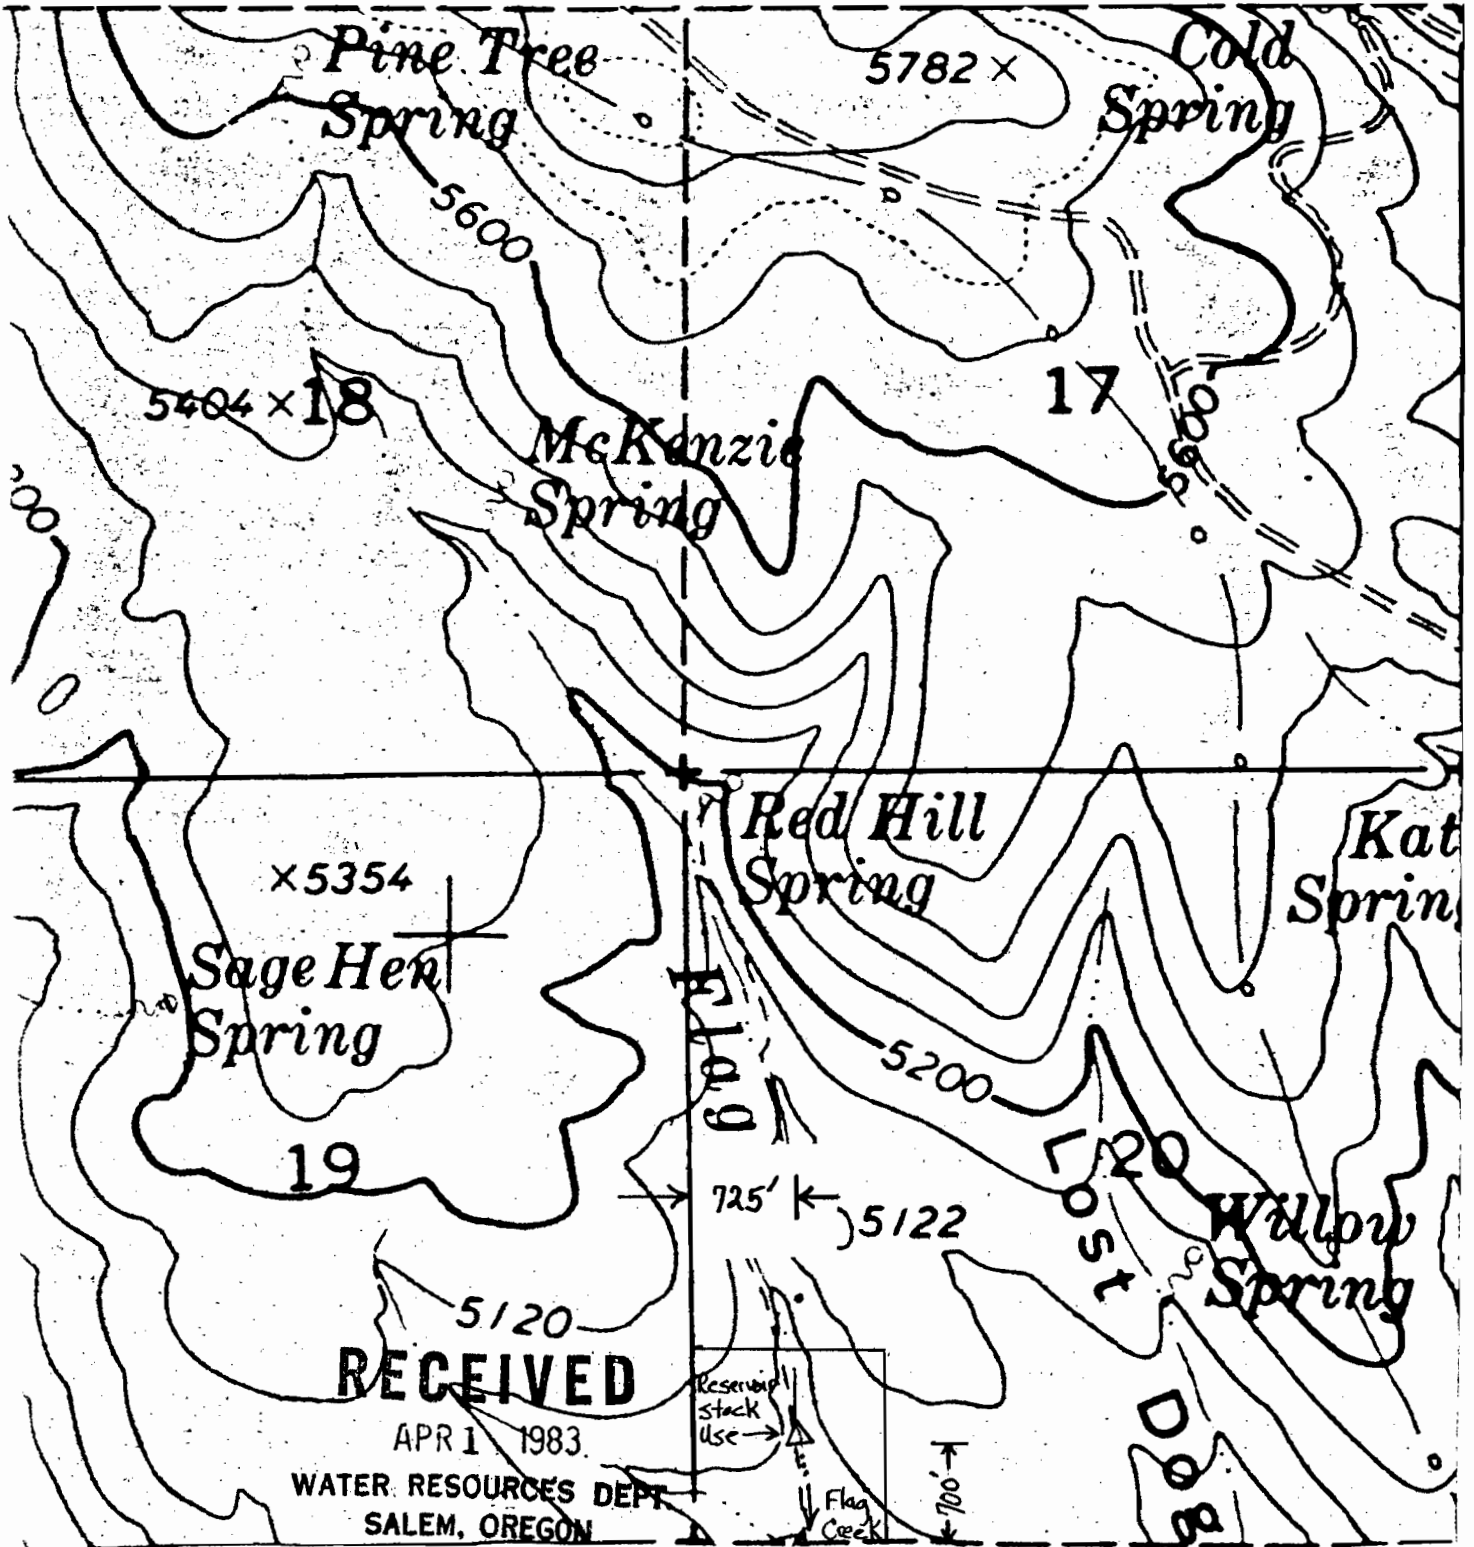

RECEIVED

APR 1 1983

WATER RESOURCES DEPT
SALEM, OREGON