

AUG 14 1981 66964

FIELD MAP SHEET

WATER RESOURCES DEPT
SALEM, OREGON


T. 40S R. 15E Sec. Subdiv. N.F.

Mapped by Reviewed by Scale 2 inches = 1 Mile

● RESERVOIR
— DRAINAGE
— ROAD

Application No. R-62265, 19

Permit No. R 9145

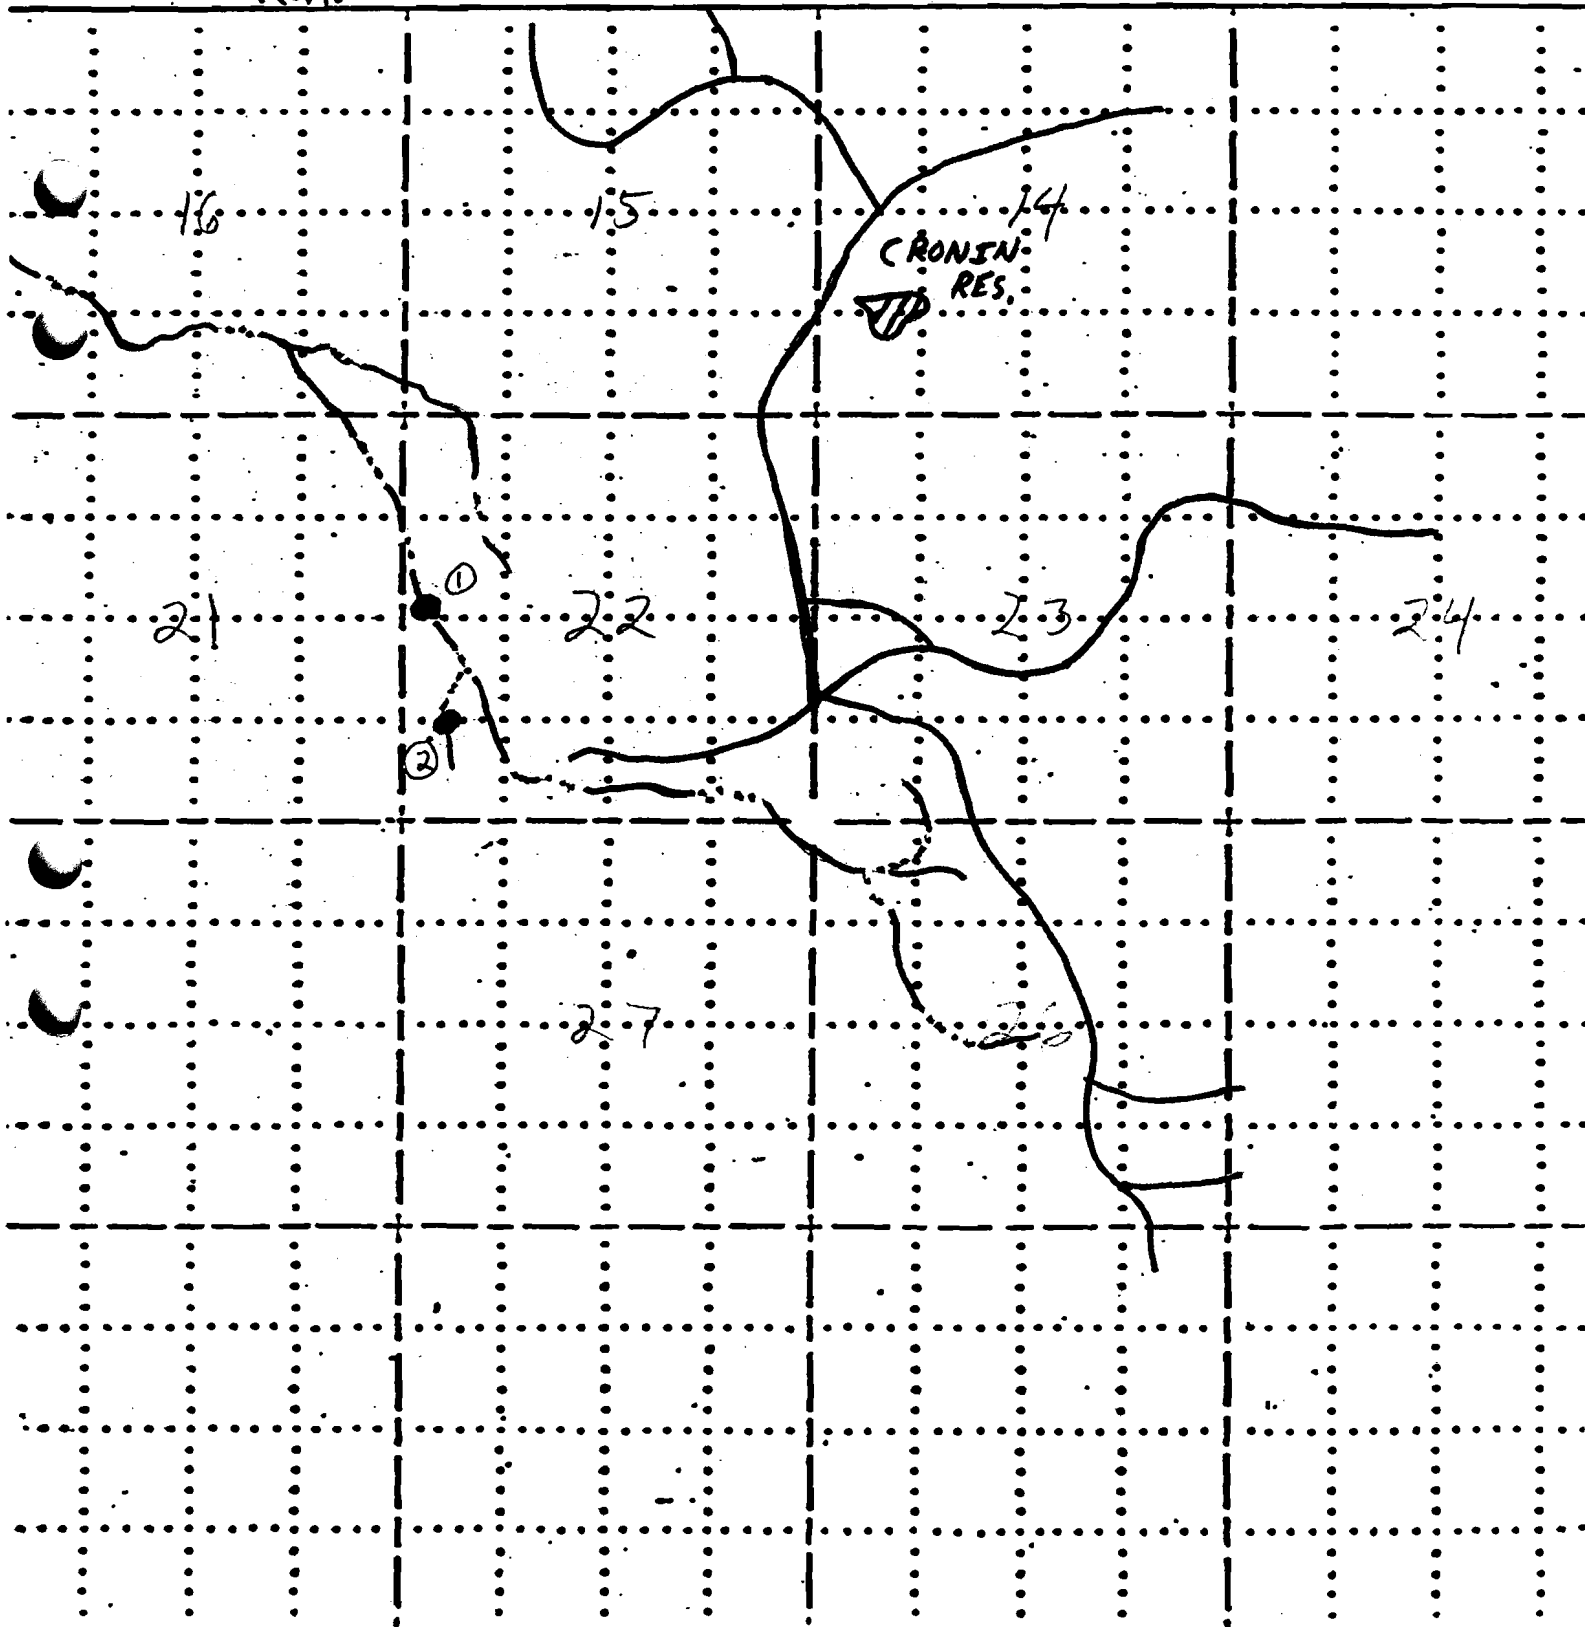

Standard

RECEIVED

AUG 14 1981

WATER RESOURCES DEPT
SALEM, OREGON

40 15 22

Application No. R-62065
Permit No. R-9145

