


RECEIVED

R9146
66965

AUG 14 1981

WATER RESOURCES DEPT
SALEM, OREGON

22 20
21
28

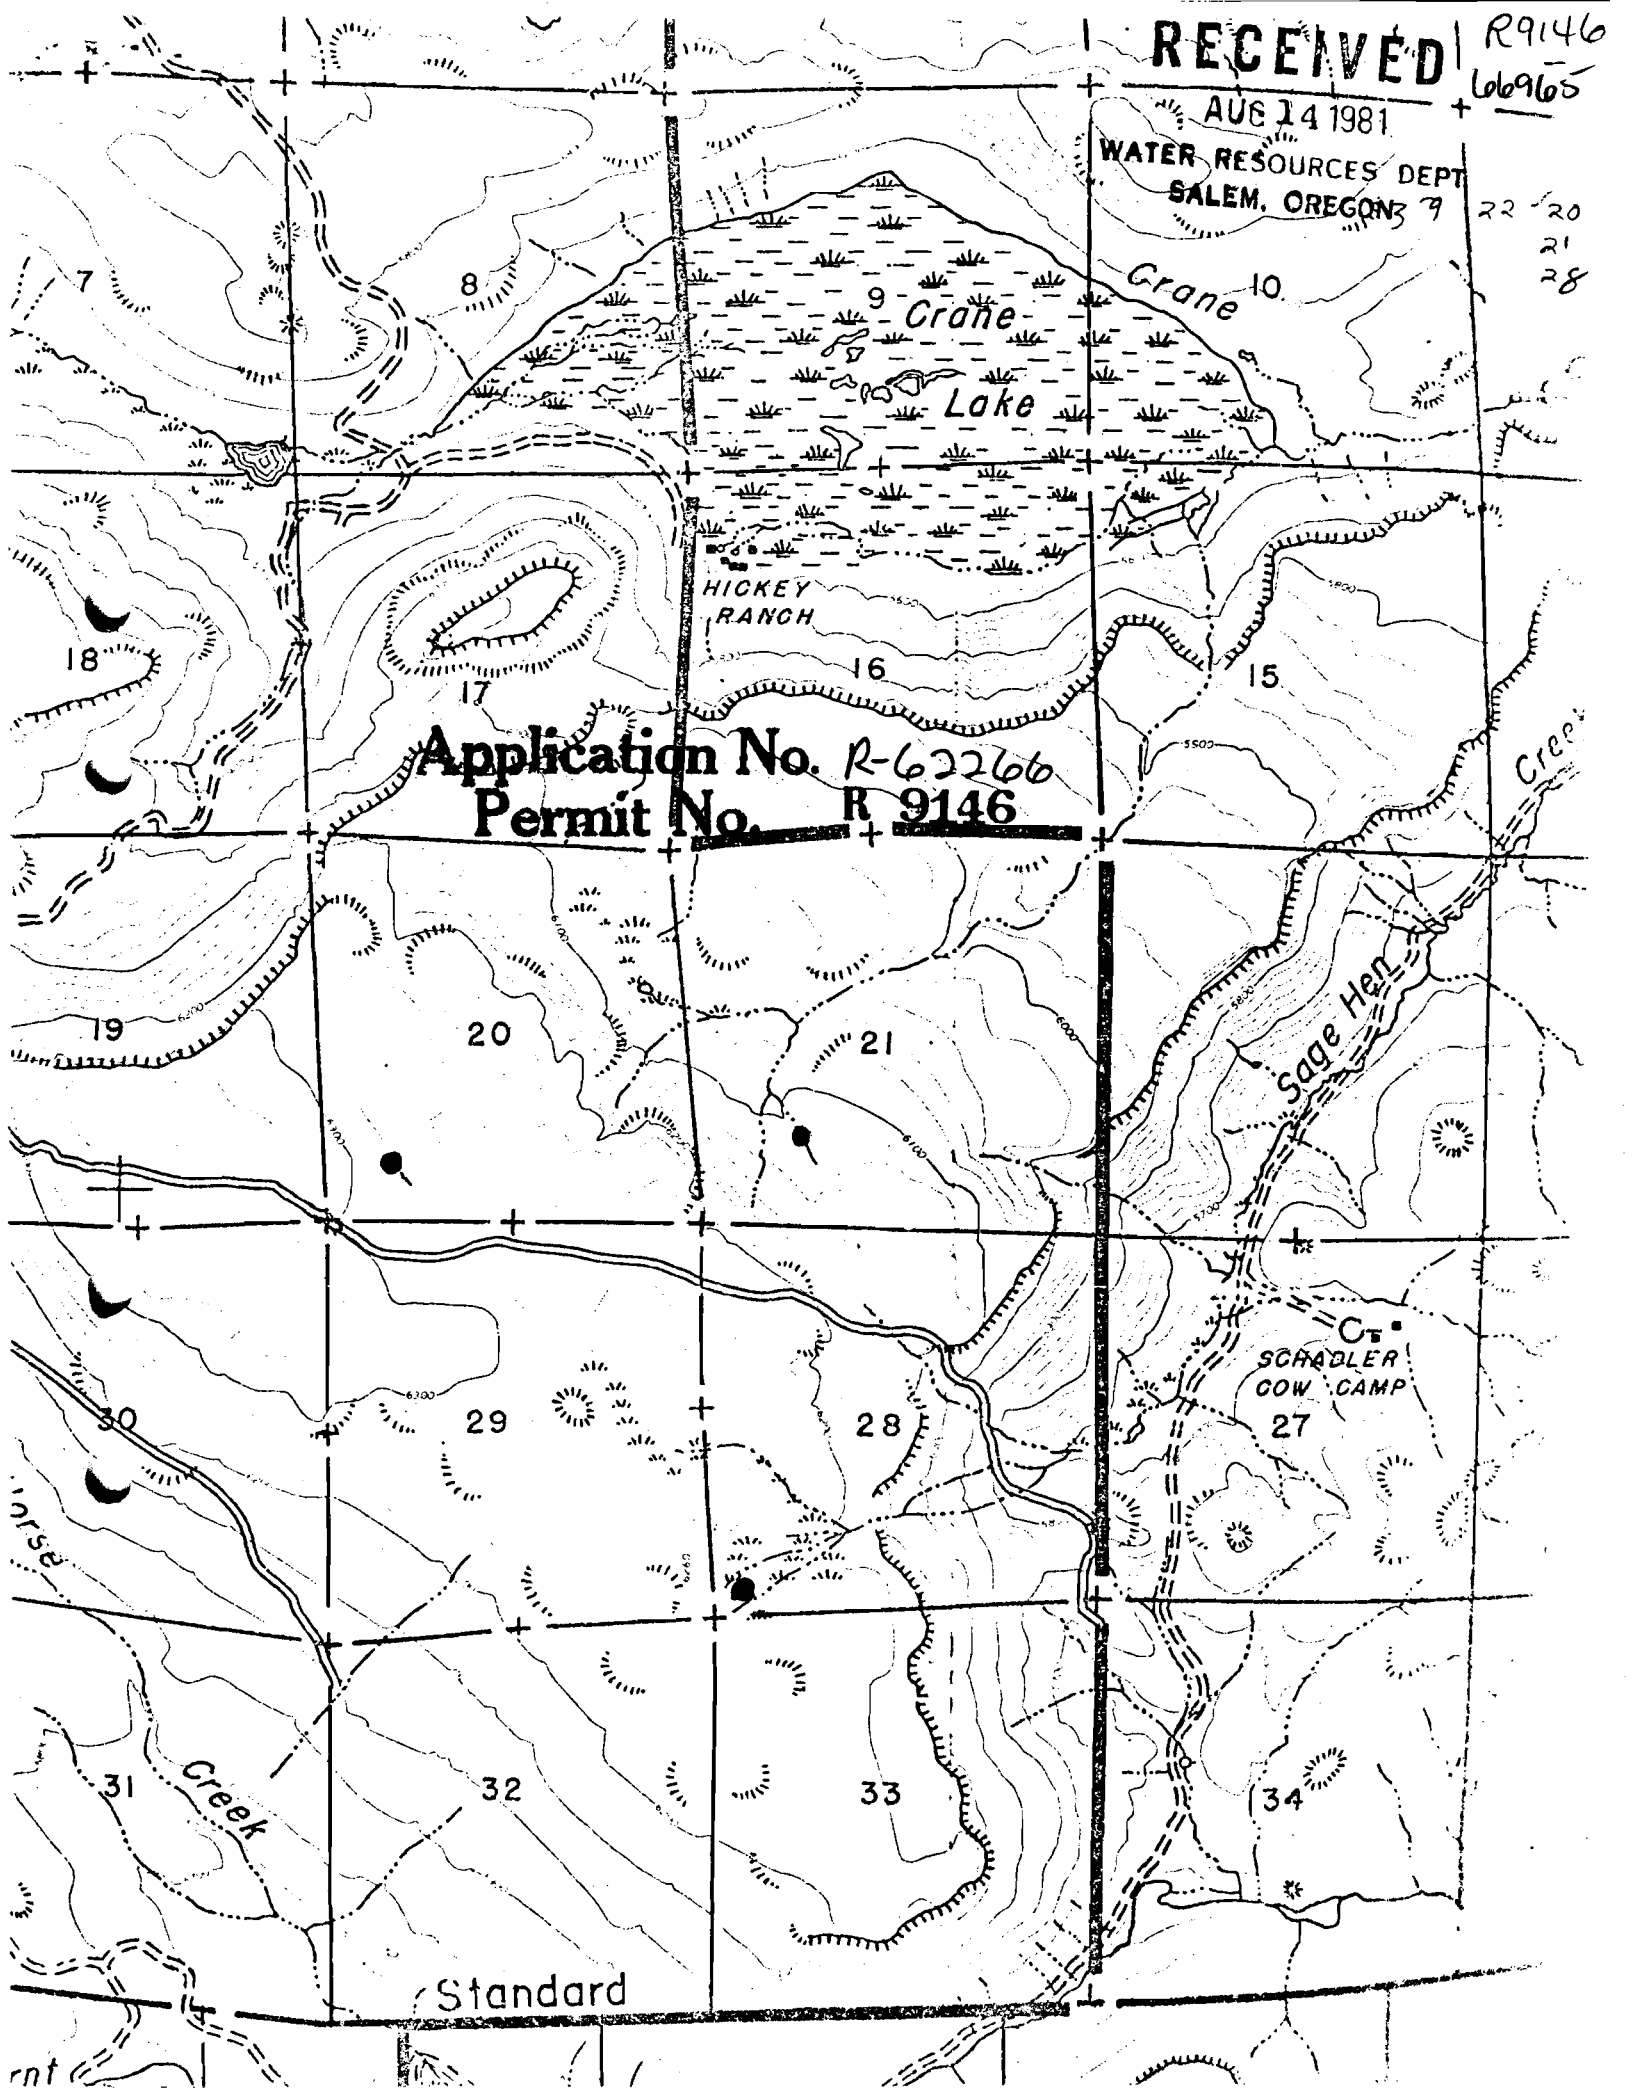

Application No. R-62266
Permit No. R 9146

SCHADLER
COW CAMP

Creek

Standard

RECEIVED

AUG 14 1981

WATER RESOURCES DEPT
SALEM, OREGON

FIELD MAP SHEET

T. 39 R. 22 Sec. _____ Subdiv. _____ N.F.

Mapped by _____ Reviewed by _____ Scale 2 inches = 1 Mile

Application No. R-62266

Permit No. _____, 19

R 9146

— ROAD
— DRAINAGE
● RESERVOIR

