

AUG 14 1981 66967


FIELD MAP SHEET

WATER RESOURCES DEPT
SALEM, OREGON

T. 40 S. R. 15 E 116 E Sec. Subdiv. N.F.

Mapped by Reviewed by Scale inches = 1 Mile

Application No. R-62270
Permit No. R 9150

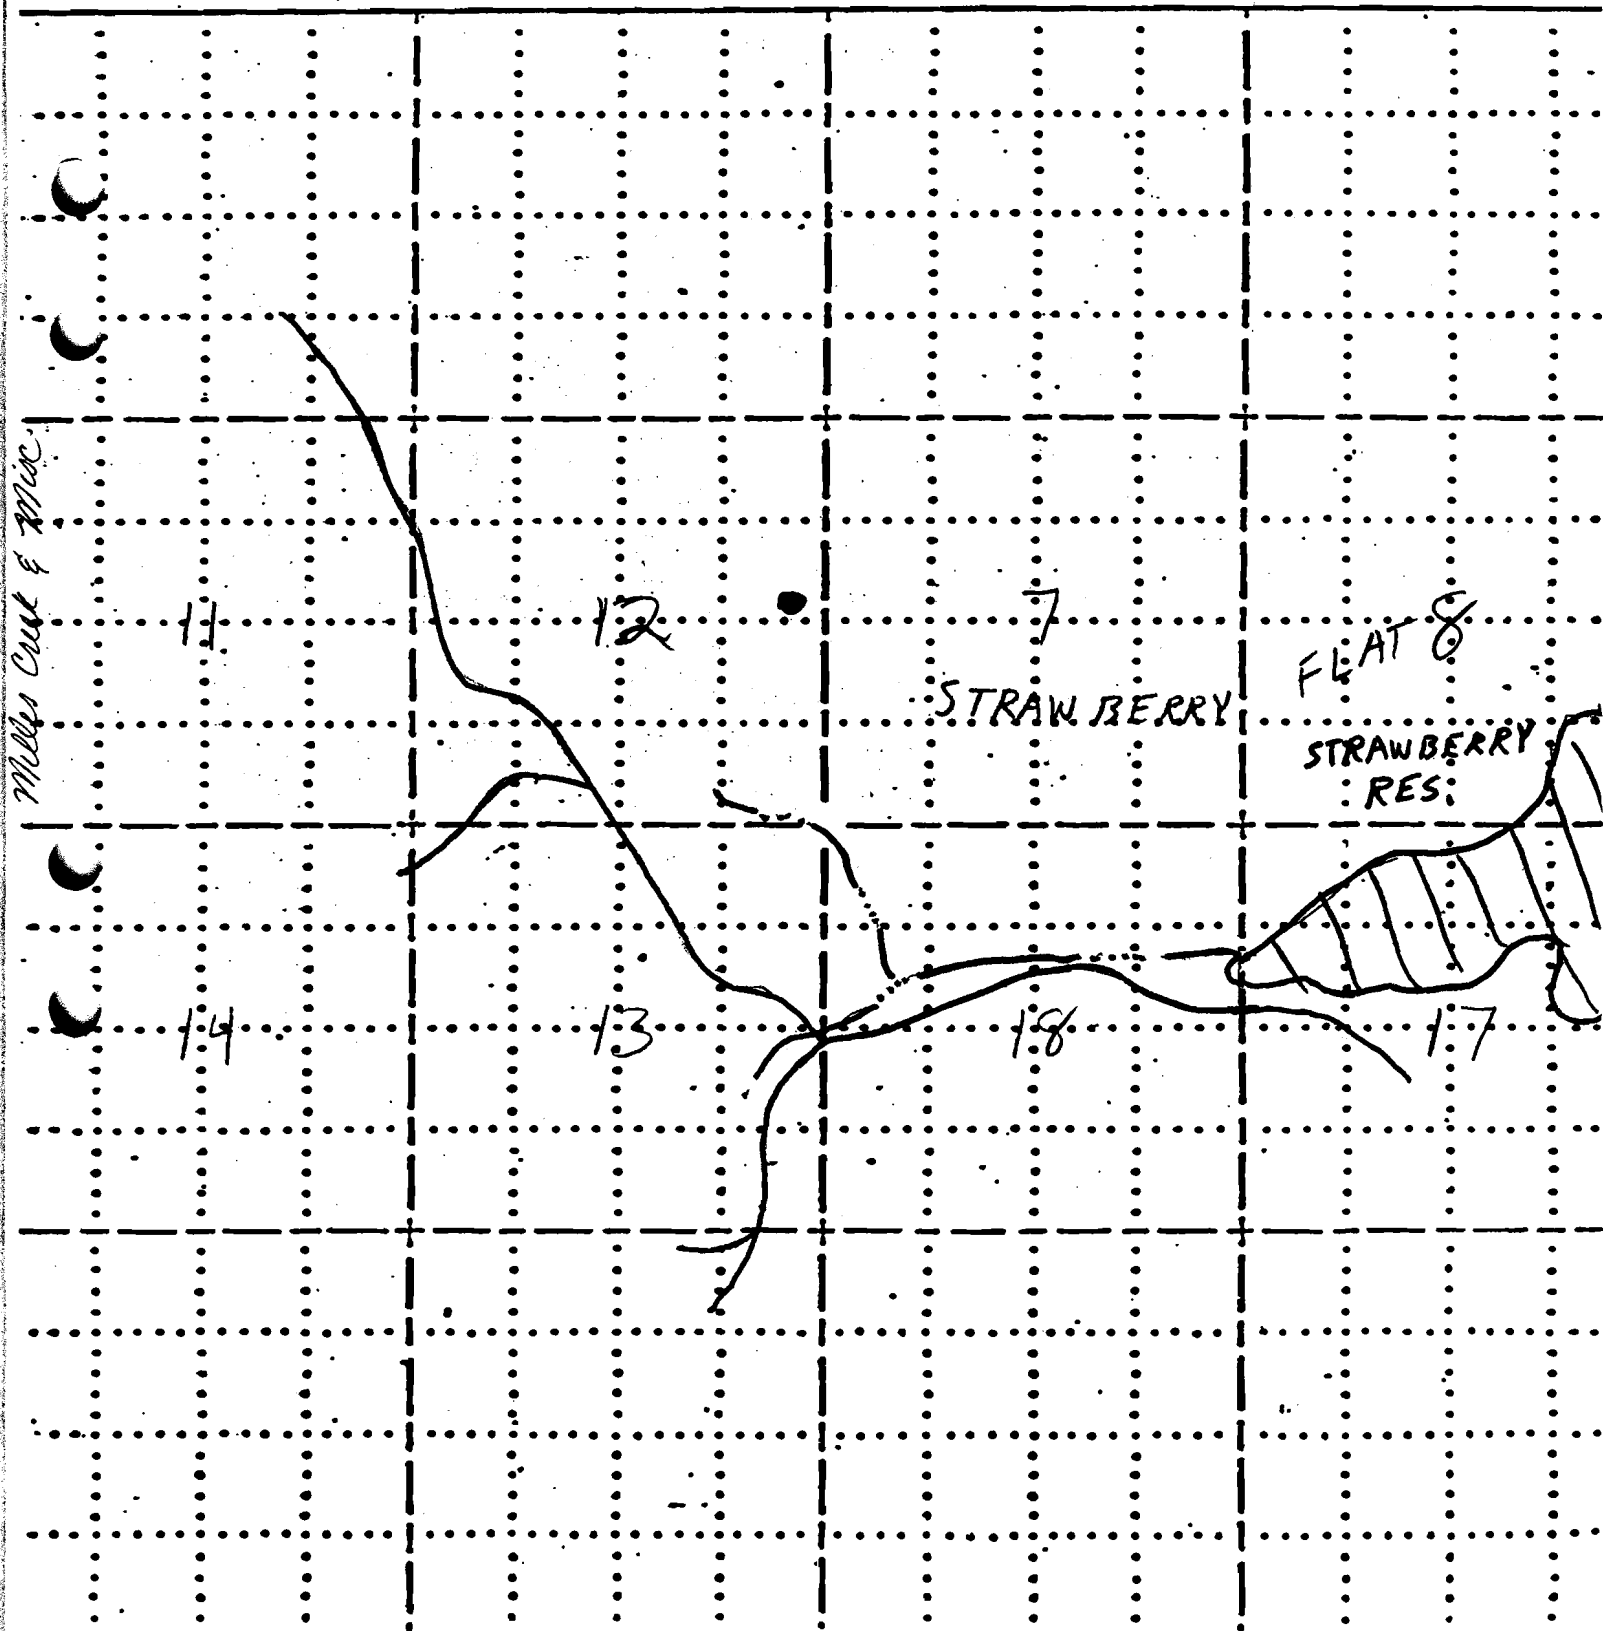

RECEIVED

AUG 24 1981

WATER RESOURCES DEPT
SALEM, OREGON

Application No. R-622705
Permit No. R 9150

