

FIELD MAP SHEET


WATER RESOURCES DEPT
SALEM, OREGON

T. 40 S R. 15 E Sec. Subdiv. N.F.

Mapped by Reviewed by Scale inches = 1 Mile

- RESERVOIR
- DRAINAGE
- ROAD

Application No. R-62271, 19
Permit No. R 9151

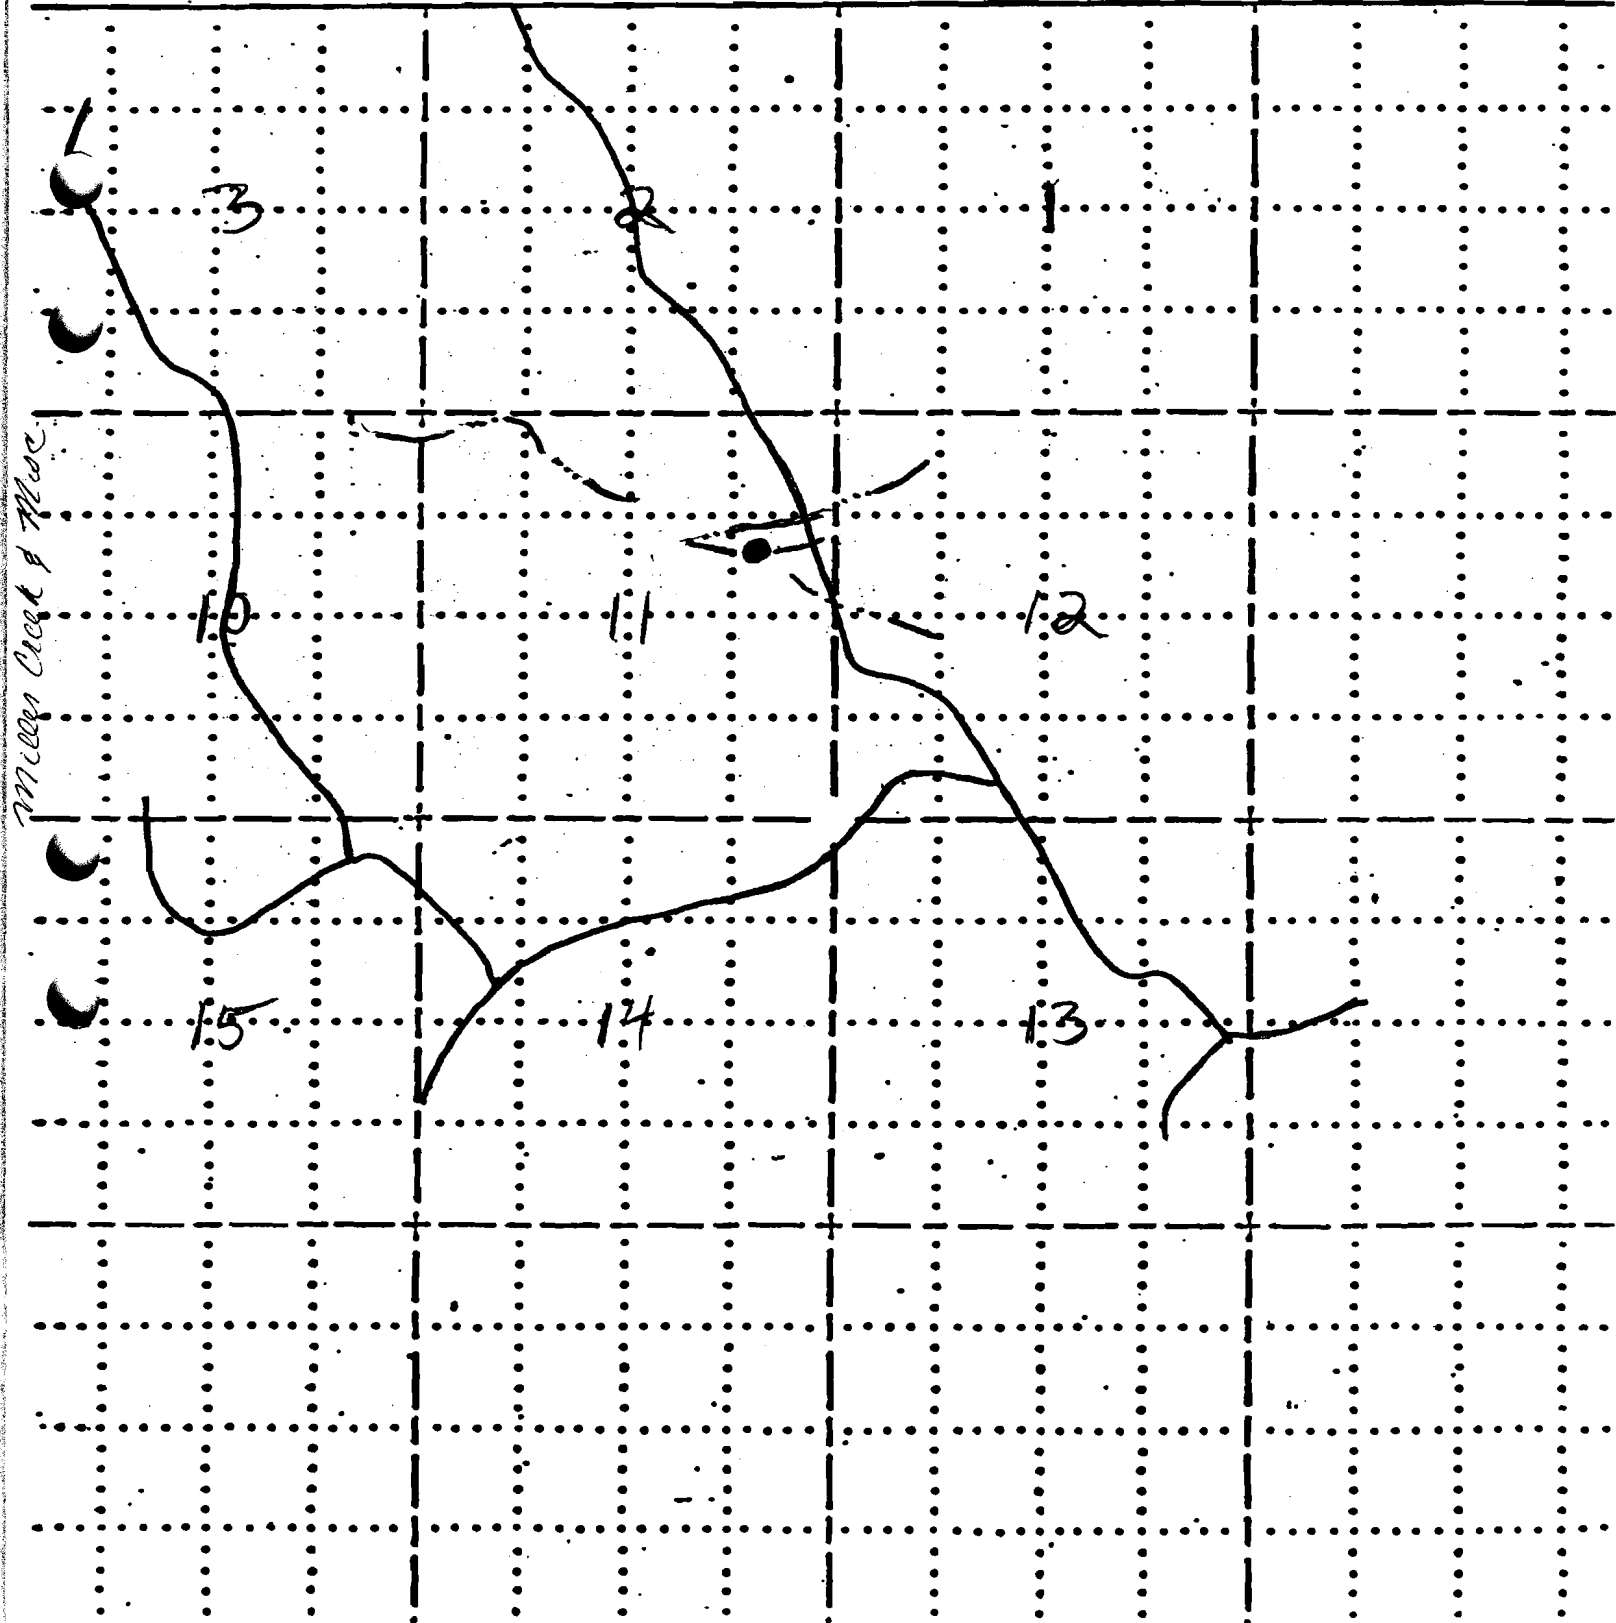

RECEIVED

AUG 14 1981

WATER RESOURCES DEPT
SALEM, OREGON

Application No. R-62271
Permit No. R 9151

Standard

Parallel

Bear Wc
5400

WALLOW
6640

Mud Spring

MUD SPR CAMP

5524
CRONIN RES.

7
Strawberry

40 15 11

Straw

Strawberry Spring

VABM
6039

Coleman Spring

Cottonwood Spring

