

26 25

Sec. Cor.

35 36

123.2'

PLAT

Accompanying application
 for permit to appropriate
 water for irrigation by
JOSEPH LOSIER
 In Section 35 T.3N.R.10E.M.M.
 Hood River, Ore.



CERTIFICATE OF SURVEYOR.

I-C.M. Hurlburt of Hood River Oregon, hereby certify that this plat was made from notes taken during an actual survey made under my supervision, on May 12th 1924 and that it correctly represents the work described in the accompanying application together with the location of streams and other ditches in the immediate vicinity.

C.M. Hurlburt.
 License No 766.

May St.

Scale - 1" = 200'

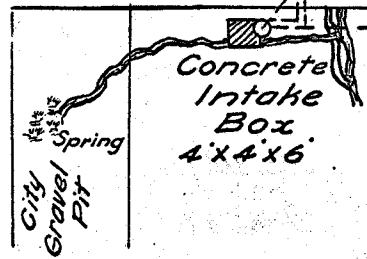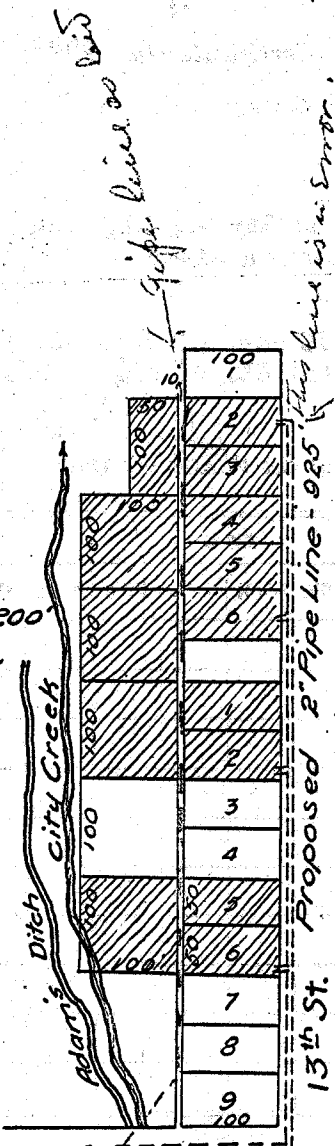

App 9501
 Rev 6286