

RECEIVED

AUG 14 1981

66972

FIELD MAP SHEET


WATER RESOURCES DEPT
SALEM, OREGON

T. 41S R. 18E Sec. _____ Subdiv. _____ N.F.

Mapped by _____ Reviewed by _____ Scale 2 inches = 1 Mile

- ROAD
- DRAINAGE
- RESERVOIR

_____, 19

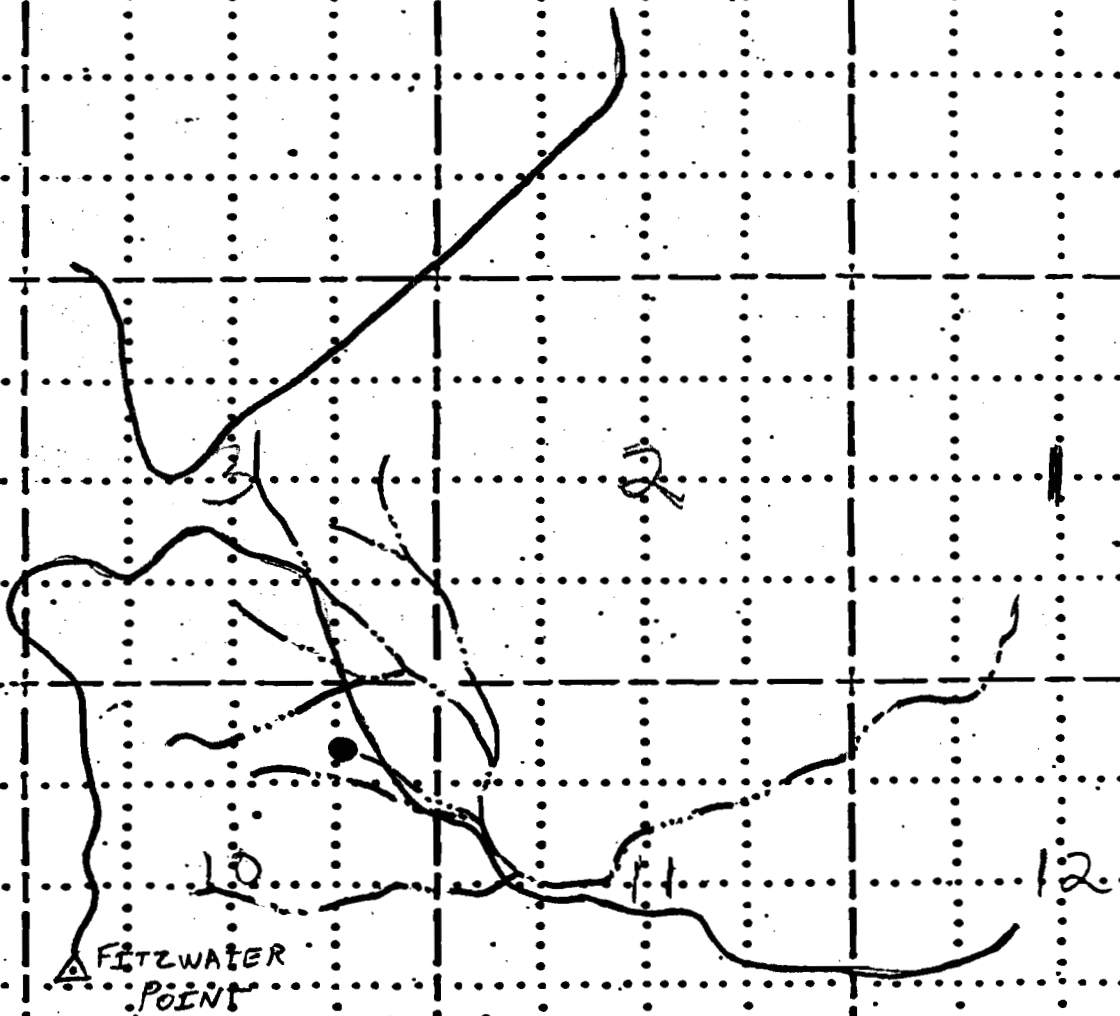


Application No. R-62278
Permit No. R 9158

RECEIVED

AUG 24 1981

WATER RESOURCES DEPT
SALEM, OREGON

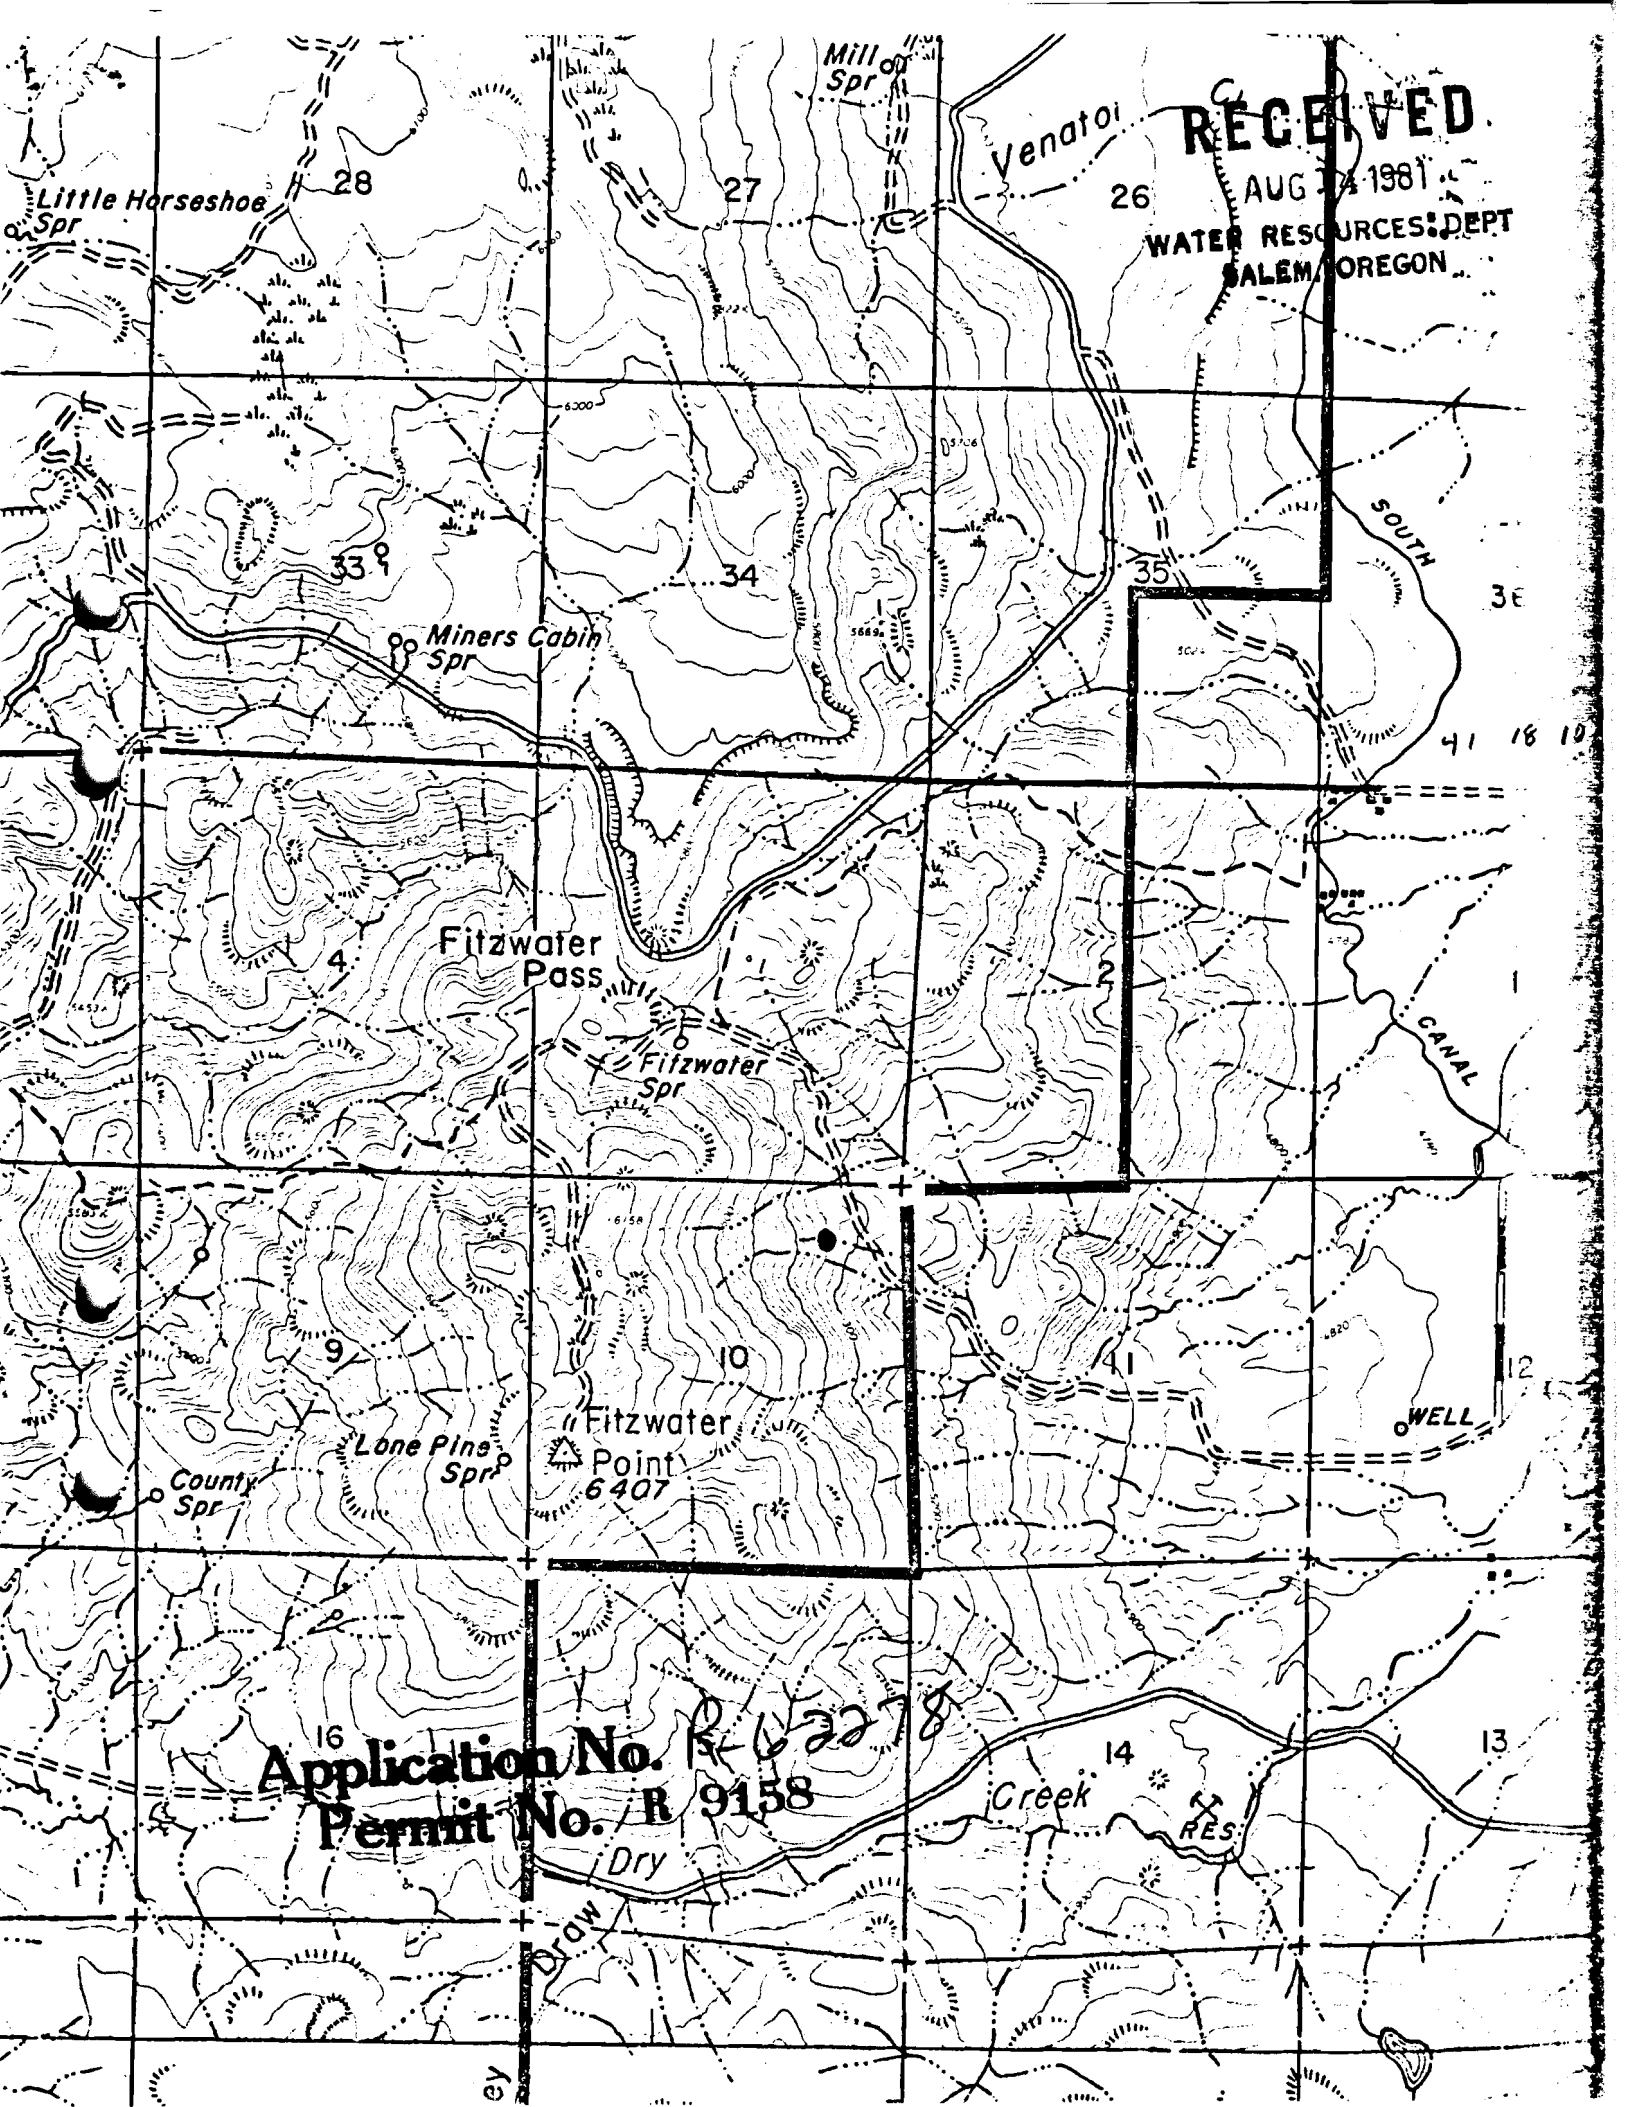

Application No. R-62278

Permit No. R 9158