

AUG 14 1981 66977

FIELD MAP SHEET

WATER RESOURCES DEPT
SALEM, OREGON


T. 40S R. 21E/22E Sec. Subdiv. N.F.

Mapped by Reviewed by Scale 2 inches = 1 Mile

● RESERVOIR
— DRAINAGE
— ROAD

19

Application No. R-62286
Permit No. R 9166

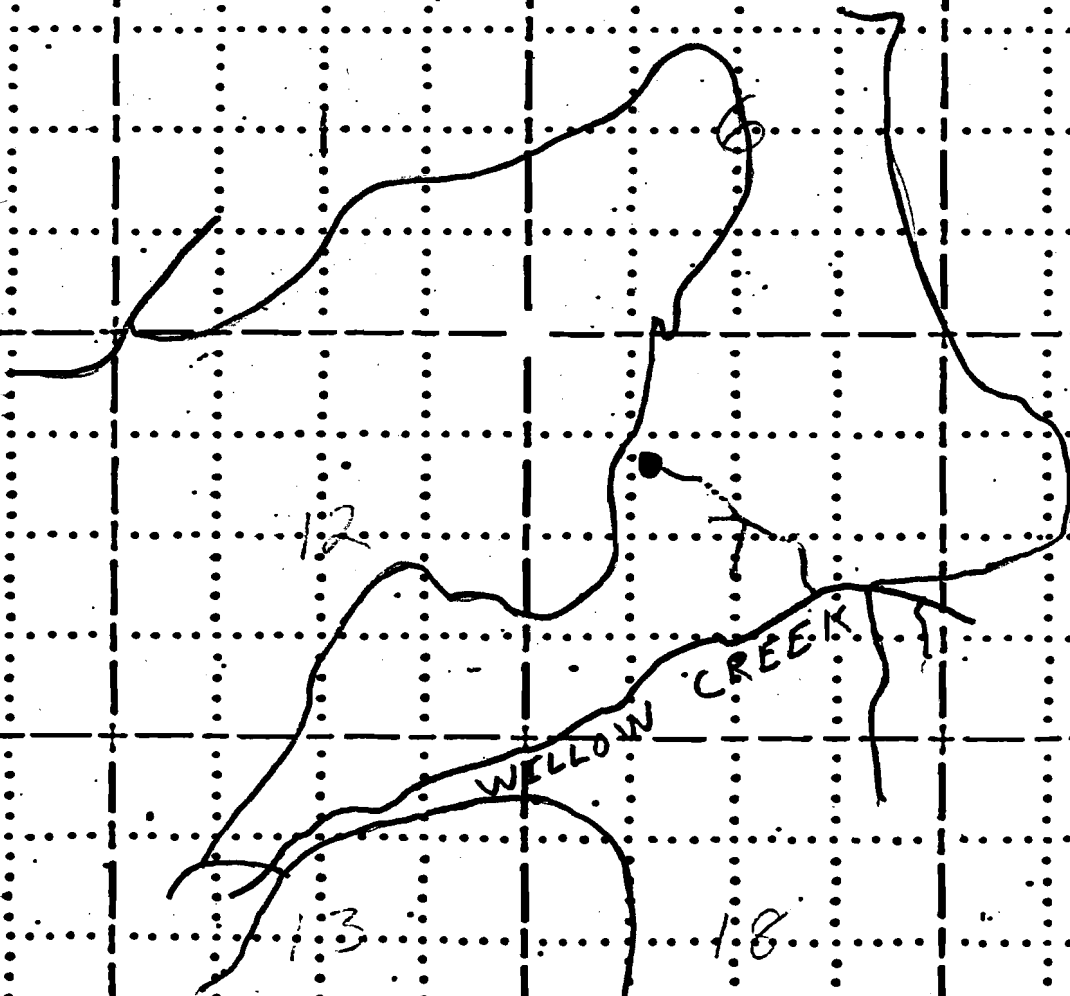

40226,7

RECEIVED
AUG 14 1981
WATER RESOURCES DEPT
SALEM, OREGON

Application No. R 62282
Permit No. B 9166

Standard

Spring
Horse Creek
Burnt Creek
Willow Creek
LOW CR
Creek
WILLOW CREEK ADM CABIN

26 25 30 29 35 36 31 32 12 7 8 9 13 18 17 16 24 19

B I G V A L