


R-9170
46980
26

RECEIVED

AUG 14 1981

WATER RESOURCES DEPT
SALEM, OREGON

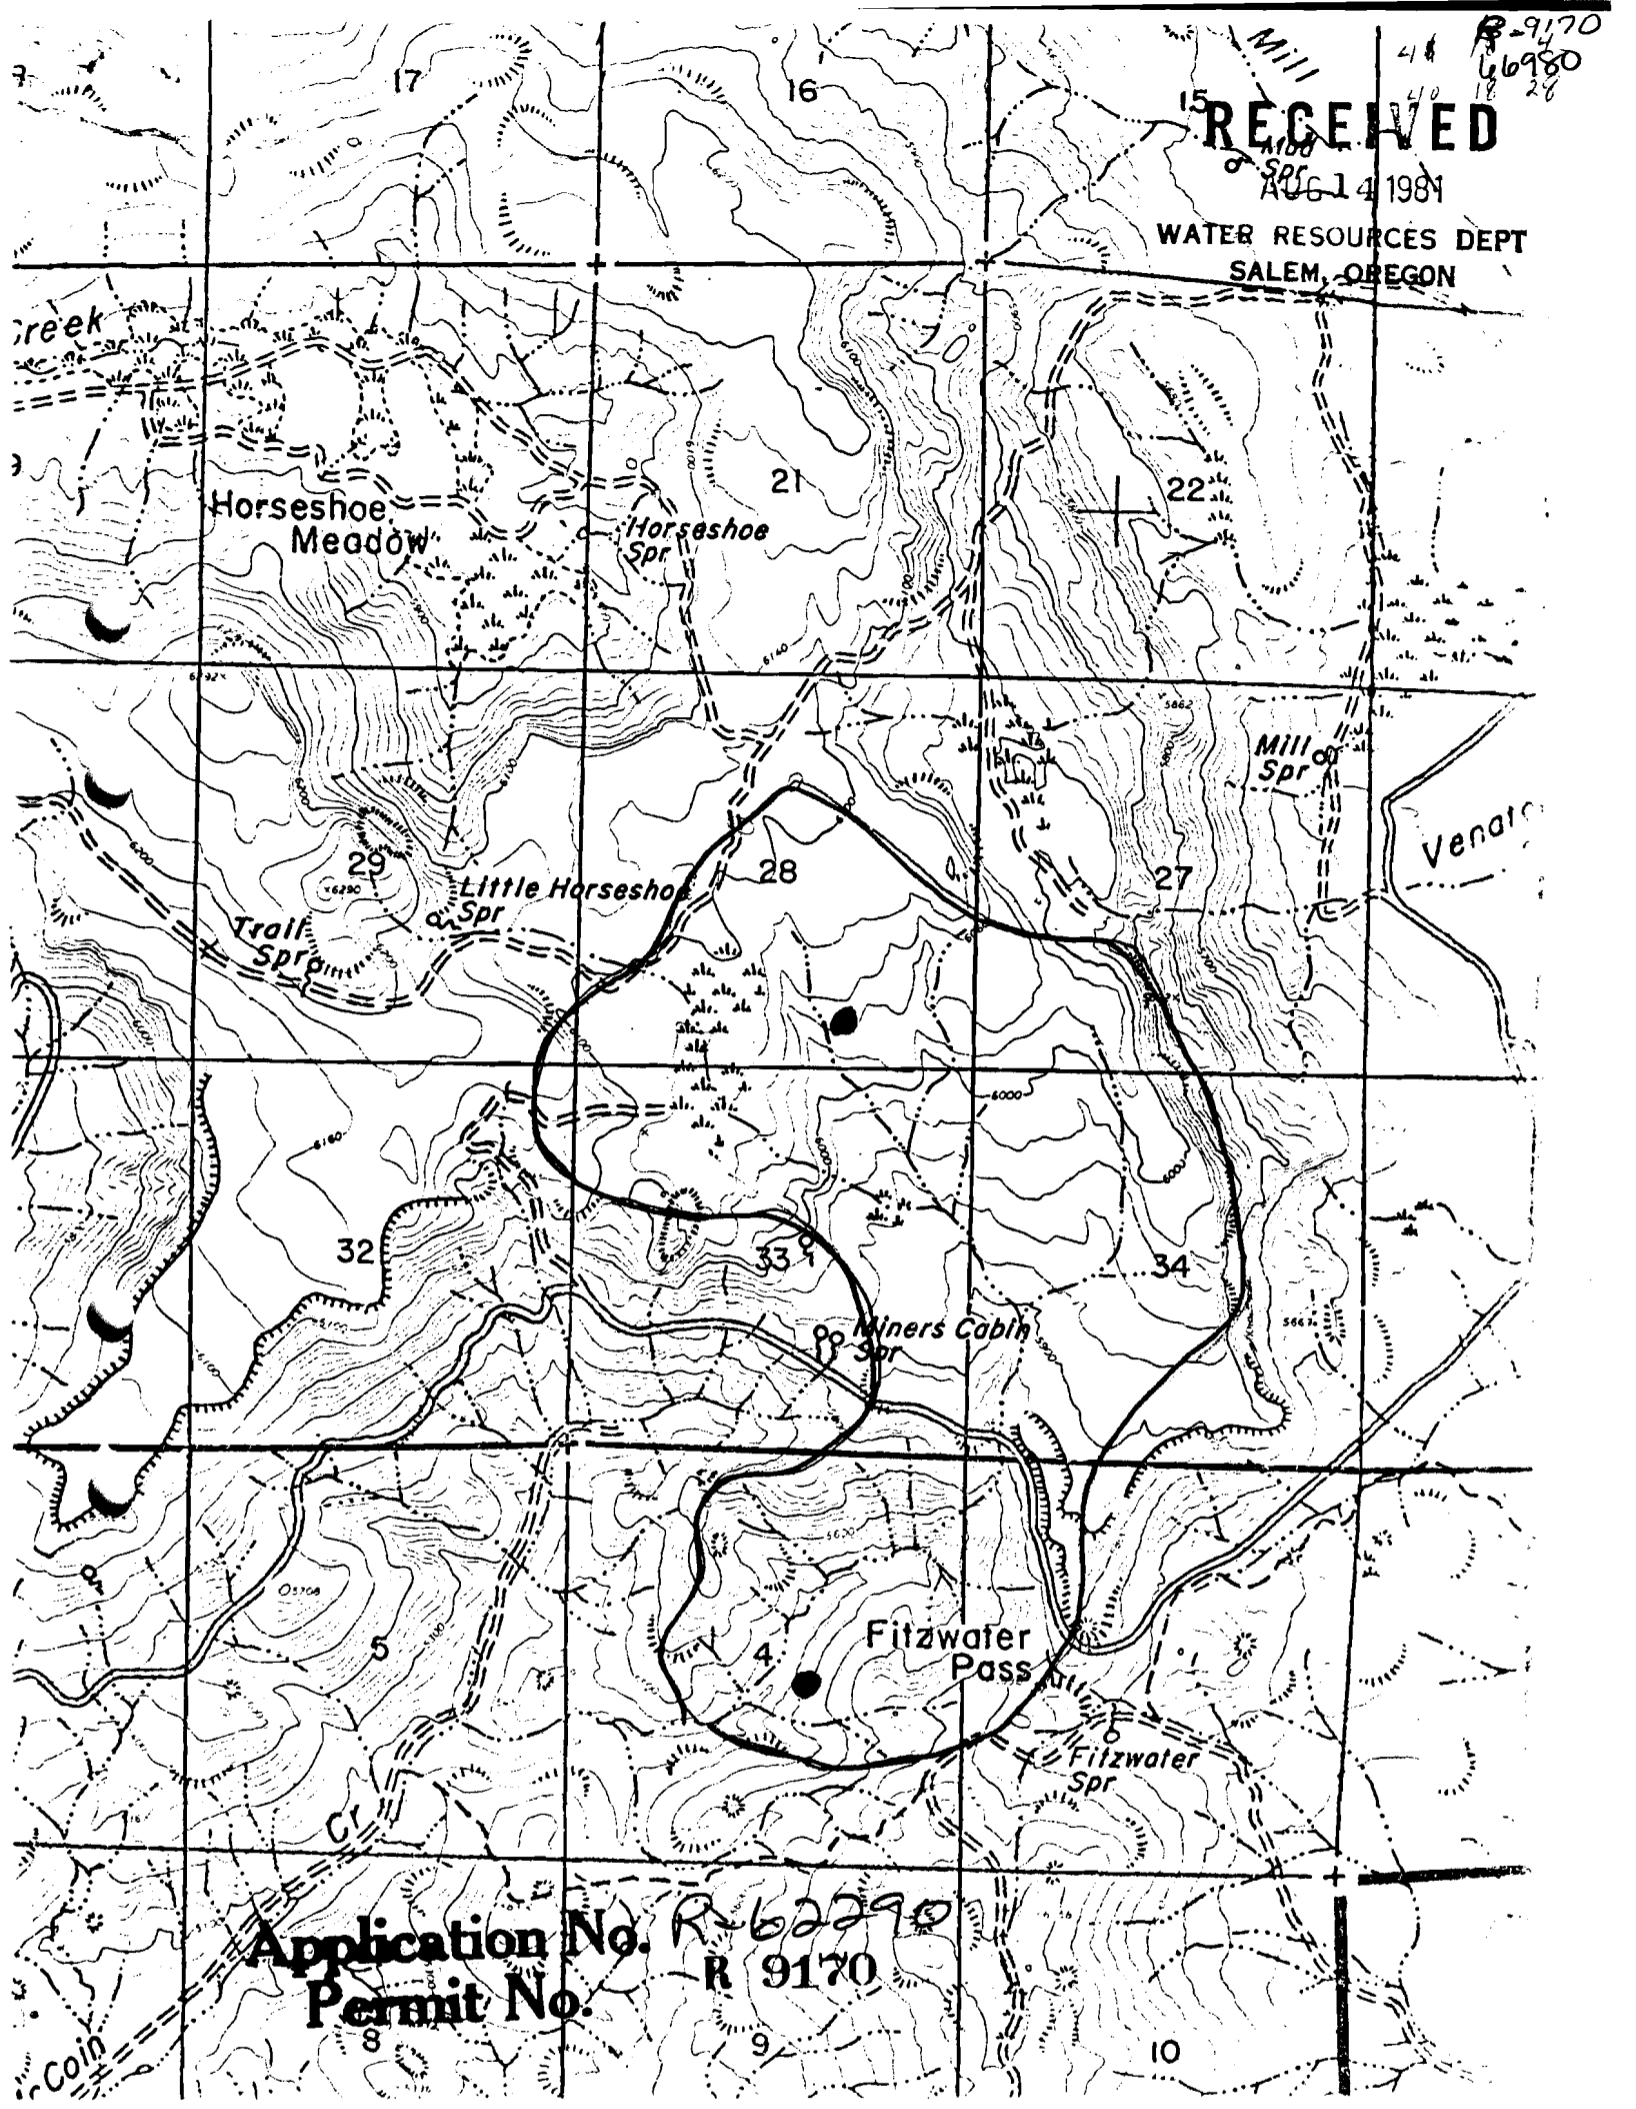

Application No. R-62290
Permit No. R 9170

RECEIVED

AUG 14 1981

FIELD MAP SHEET


WATER RESOURCES DEPT
SALEM, OREGON

T. ³⁹⁵455 R. ¹1 E. Sec. Subdiv. N.F.

Mapped by _____ Reviewed by _____ Scale ² inches = 1 Mile

- RESERVOIR
- DRAINAGE
- ROAD

_____, 19

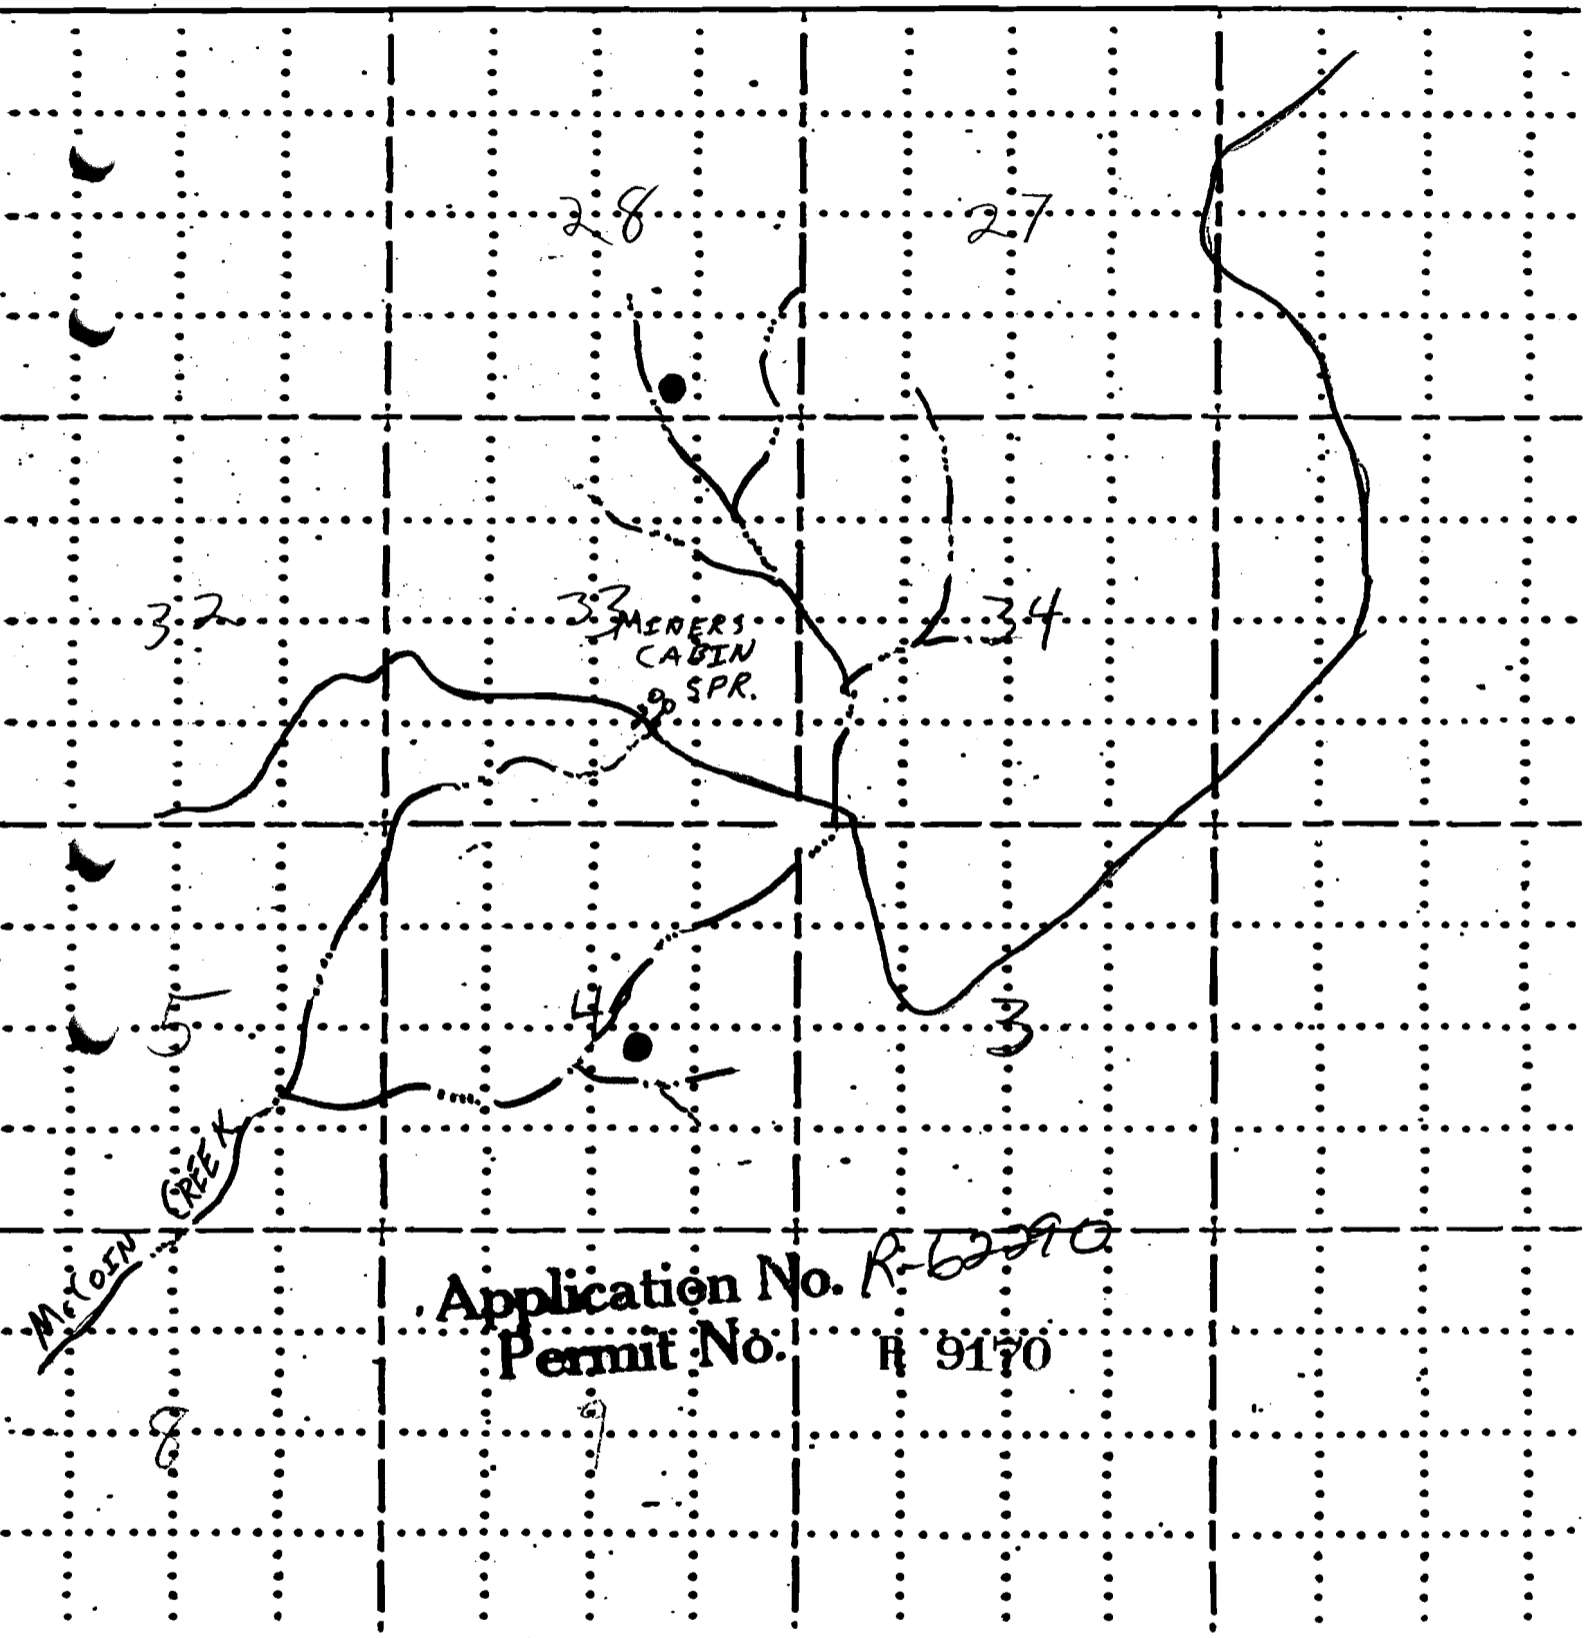

Application No. R-6290
Permit No. R 9170