


R9171
66981

RECEIVED

AUG 14 1981

WATER RESOURCES DEPT
SALEM, OREGON

41 18 3

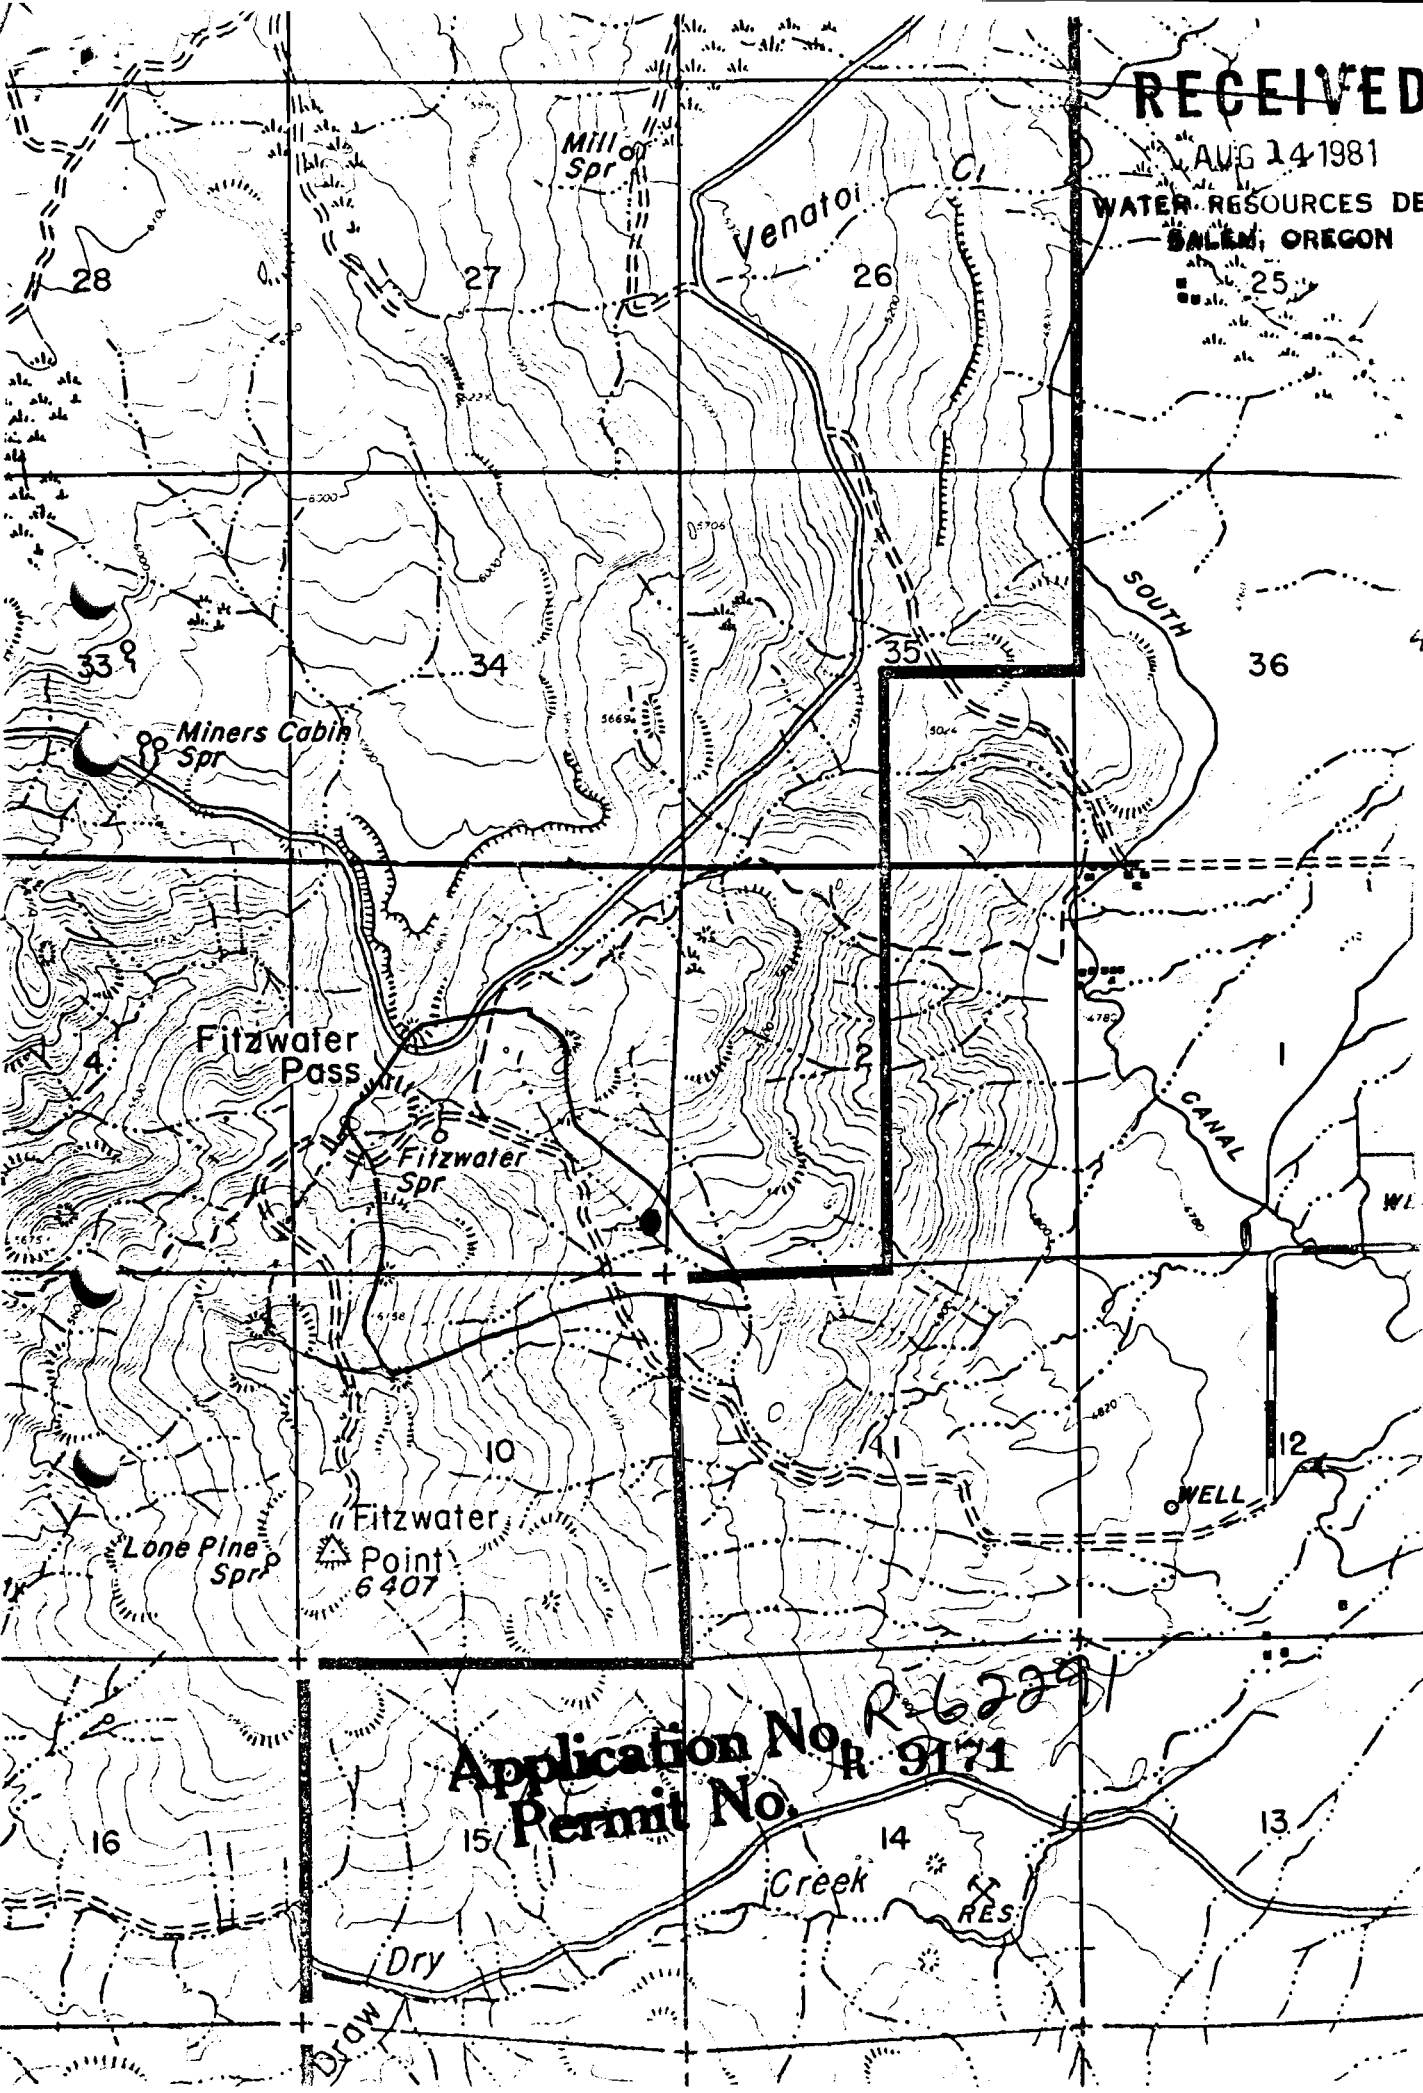

Application No. R-62291
Permit No. R-9171

AUG 14 1981

FIELD MAP SHEET

WATER RESOURCES DEPT
SALEM, OREGON

T. 42S R. 18E Sec. _____ Subdiv. _____ N.E.

Mapped by _____ Reviewed by _____ Scale 2 inches = 1 Mile

● RESERVOIR
— DRAINAGE
— ROAD

_____, 19

3.3

3.4

3.5

4

3.1

2

FITZWATER
SPRING

9

10

11

FITZWATER
POINT

Application No. R-62291
Permit No. R-9171