

TBR, C

AUG 14 1981

WATER RESOURCES DEPT
SALEM, OREGON


FIELD MAP SHEET

T. ^{40S}_{41S} R. 18E Sec. Subdiv. N.F.

Mapped by Reviewed by Scale 2 inches = 1 Mile

- RESERVOIR
- DRAINAGE
- ROAD

19

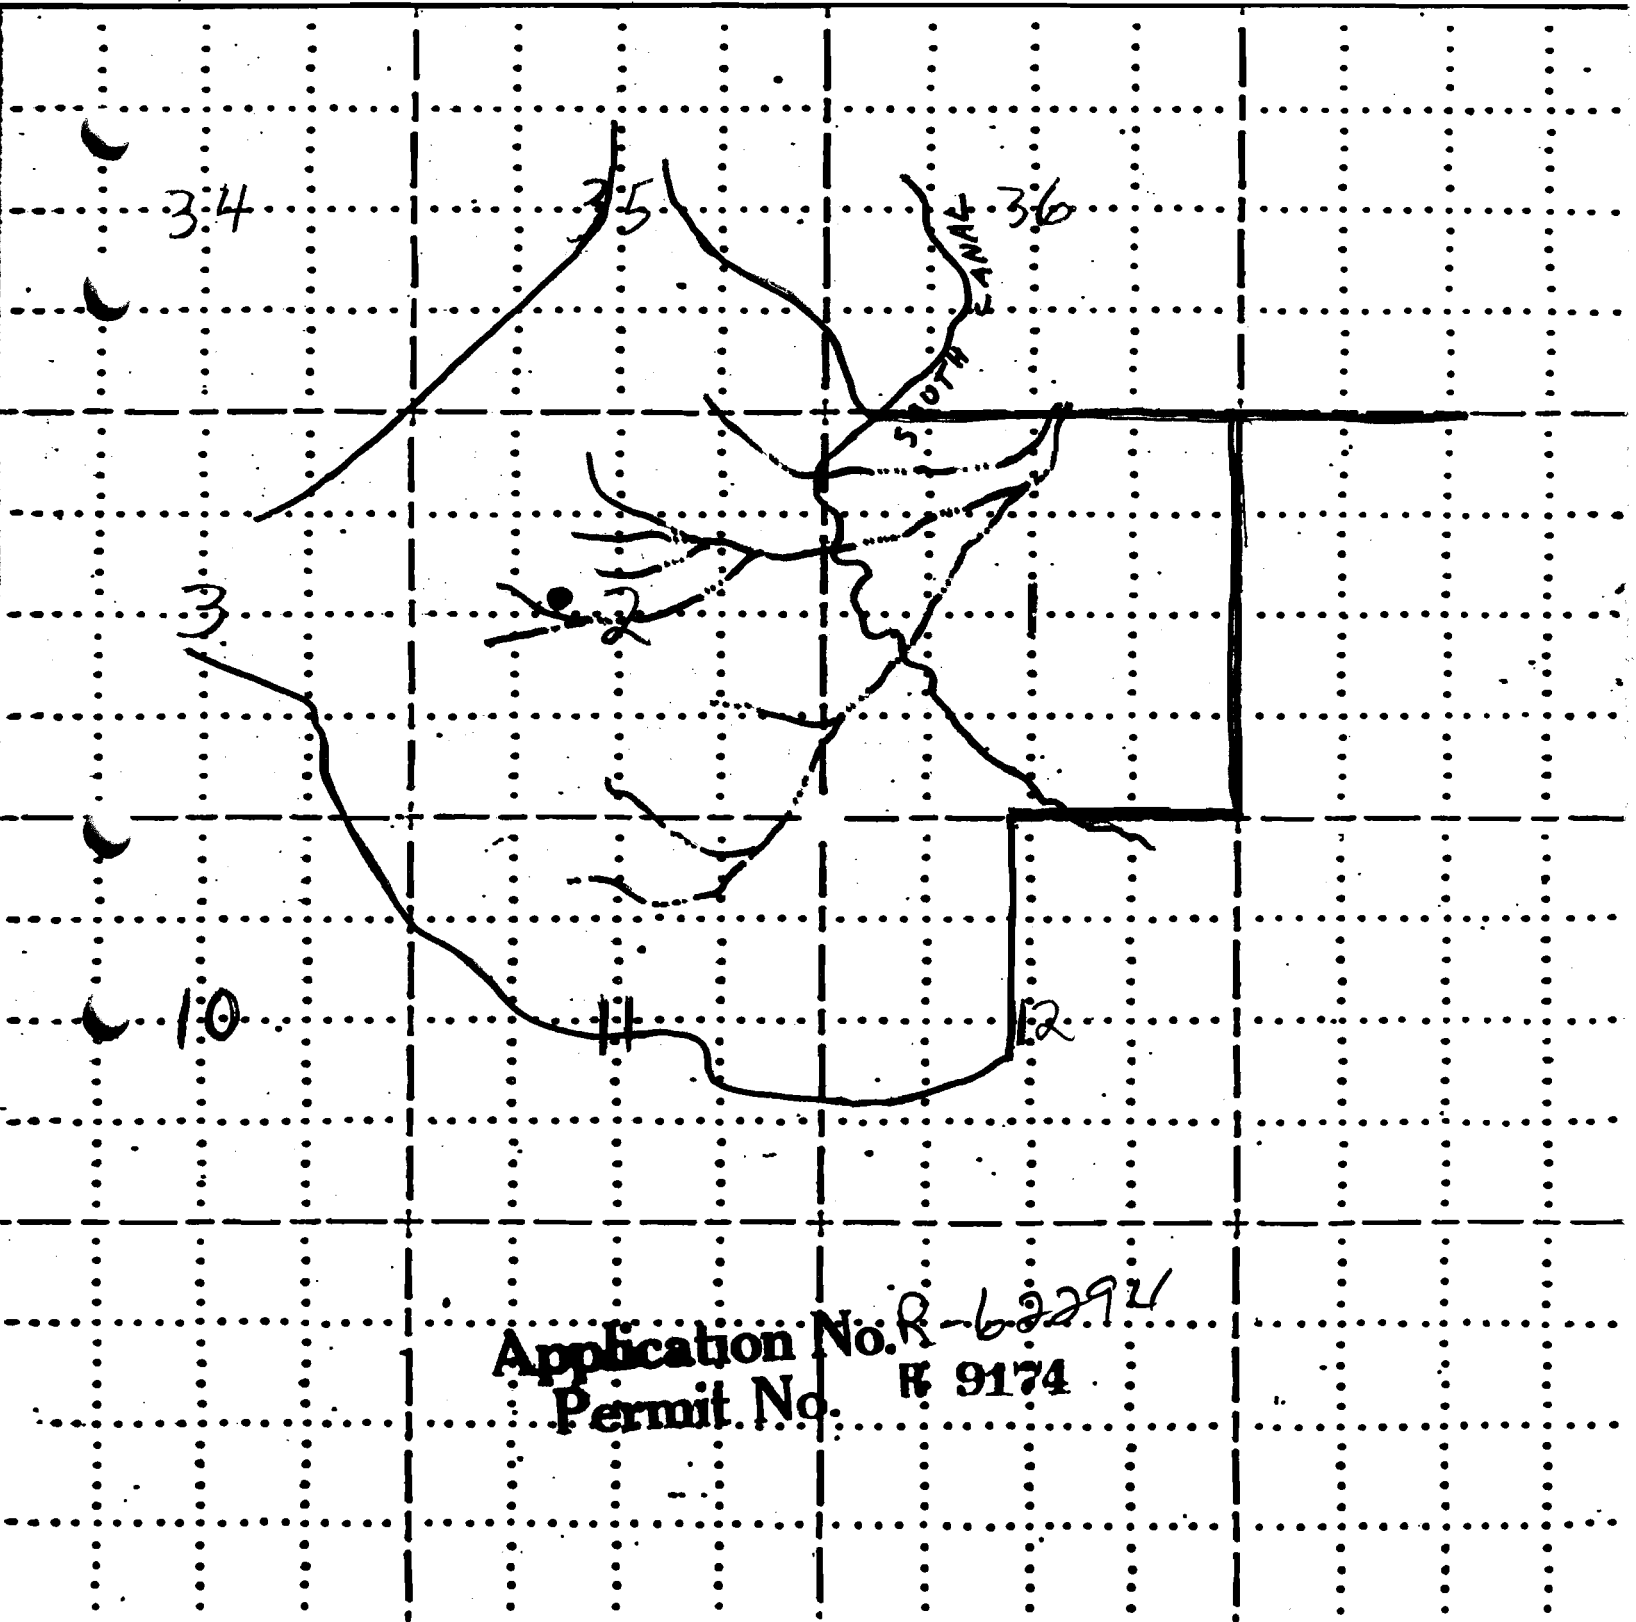

Application No. R-62294
Permit No. R 9174