


R 9176
66984

RECEIVED
AUG 14 1981
WATER RESOURCES DEPT
SALEM, OREGON

RECEIVED
AUG 14 1981
WATER RESOURCES DEPT
SALEM, OREGON

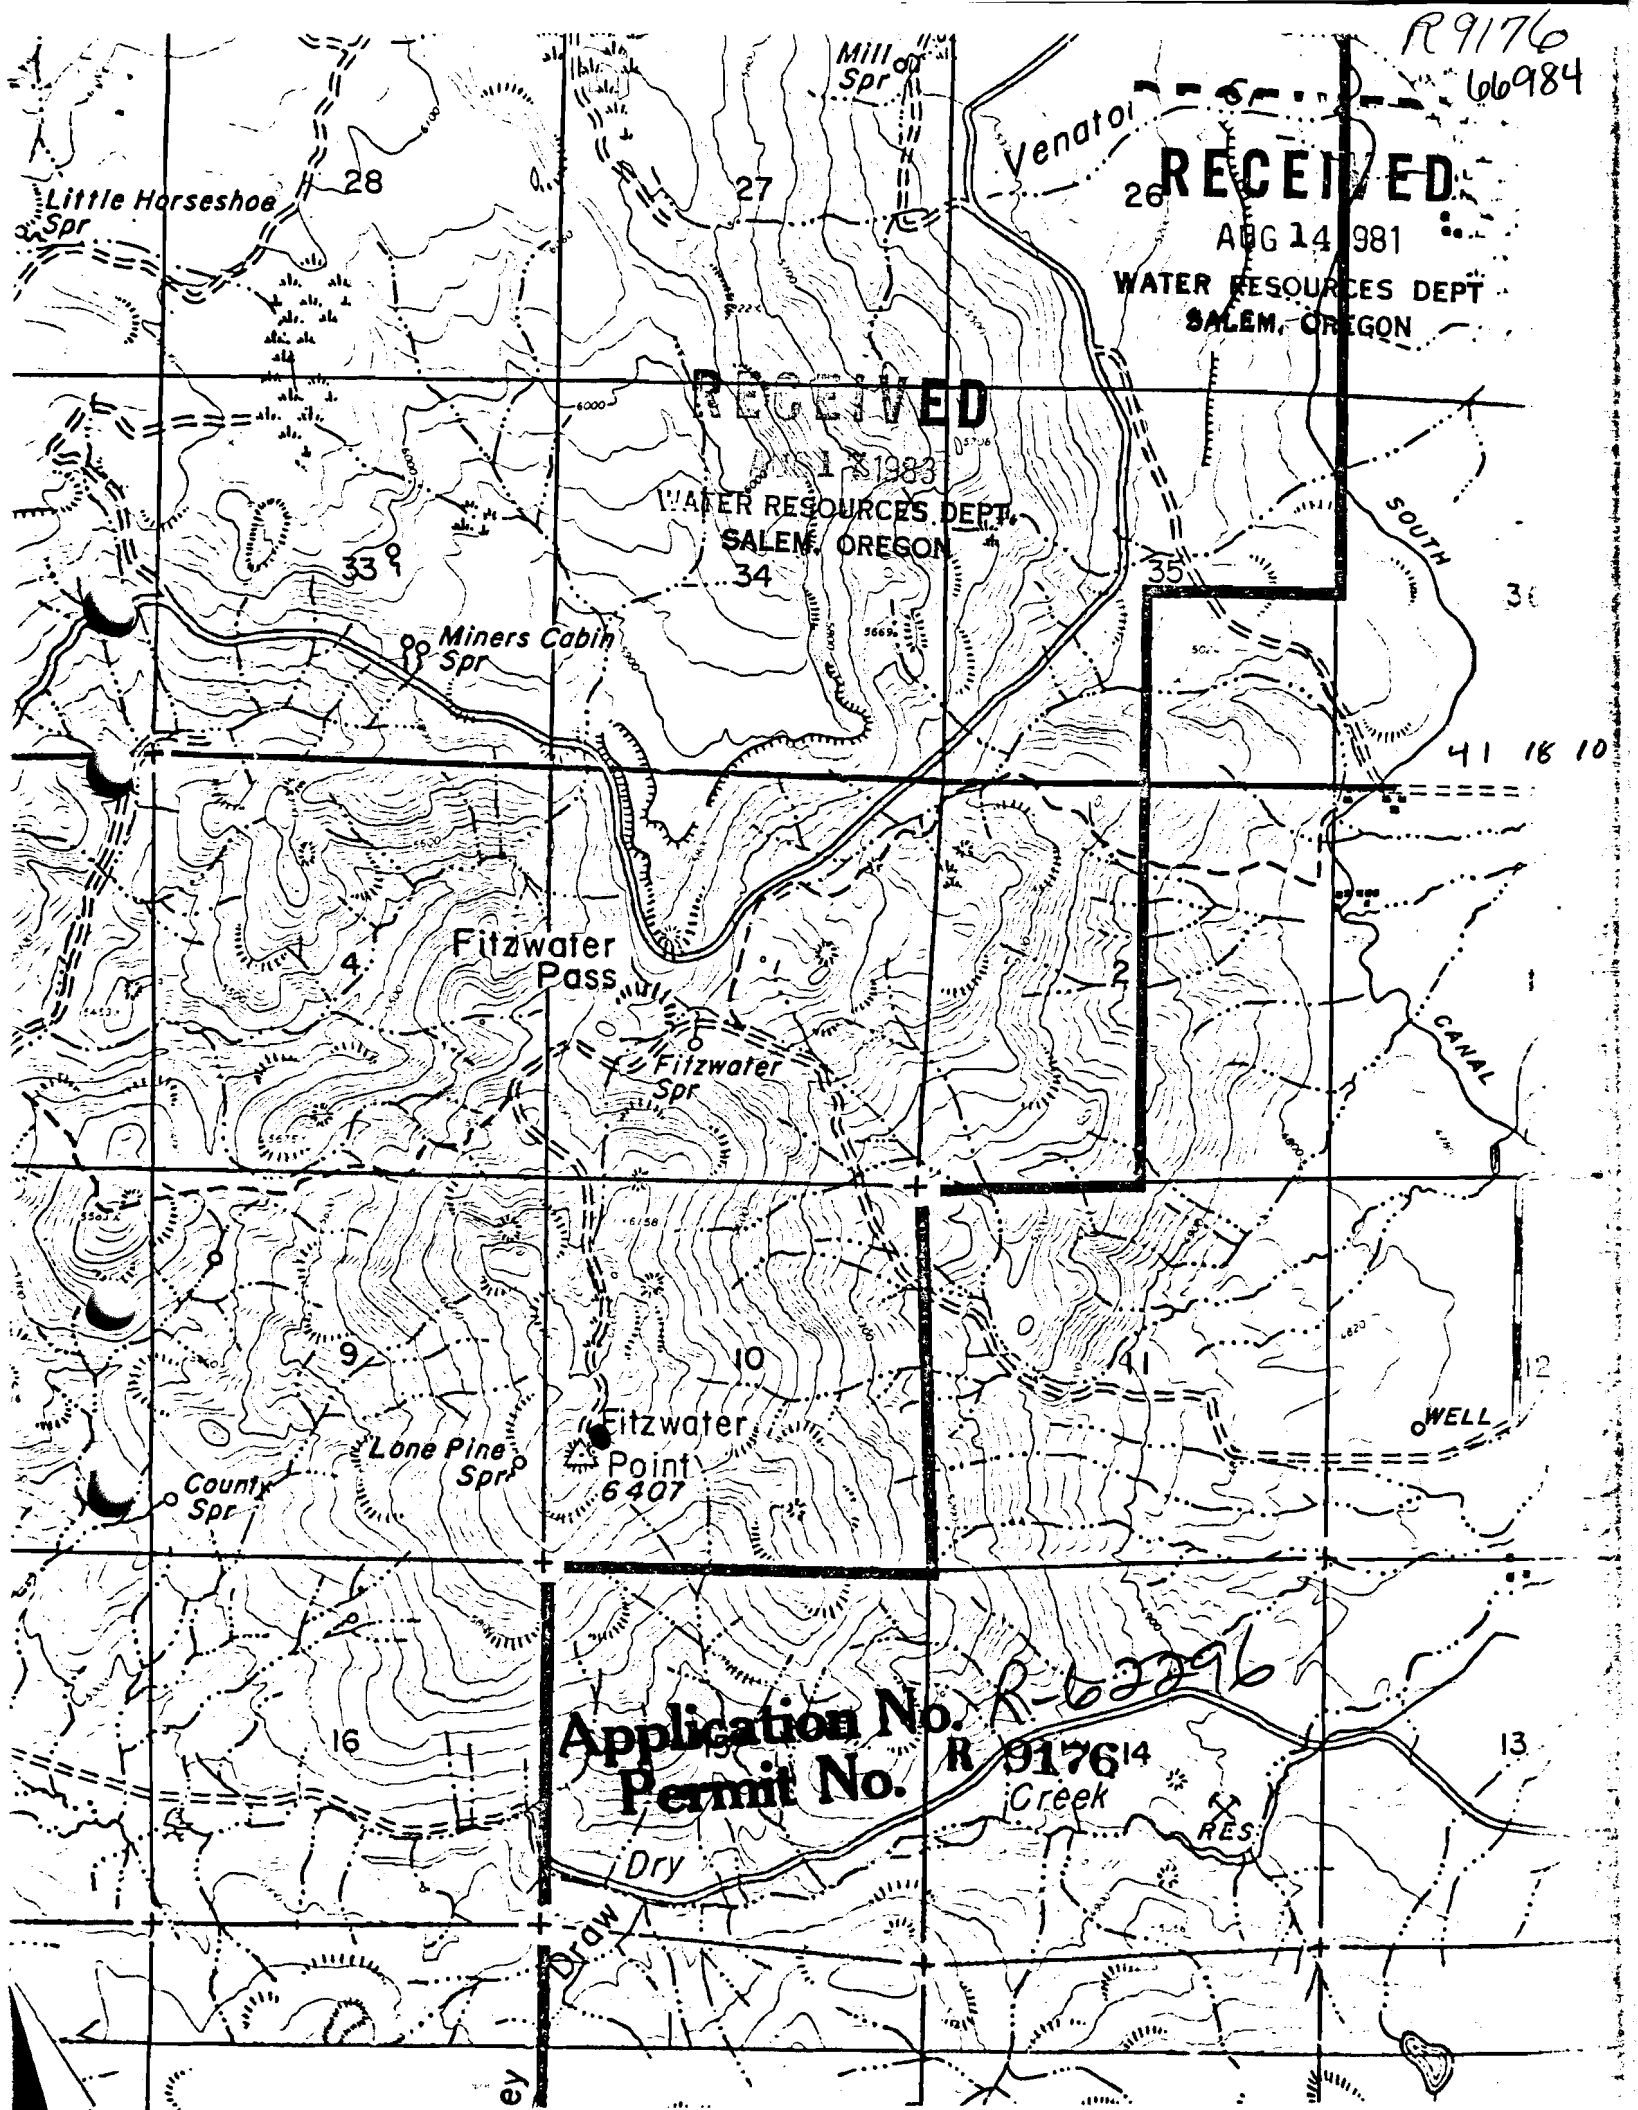

Application No. R-62296
Permit No. R 917614

AUG 14 1981

FIELD MAP SHEET

WATER RESOURCES DEPT
SALEM, OREGON

T. 41S R. 18E Sec. Subdiv. N.F.

Mapped by Reviewed by Scale inches = 1 Mile

● RESERVIOR

— ROAD

19

3
9
10
11
FETZ WATER
POINT
15

Application No. R-62296
Permit No. R 9176

RECEIVED

AUG 17 1983

WATER RESOURCES DEPT.
SALEM, OREGON