

AUG 14 1981


FIELD MAP SHEET WATER RESOURCES DEPT
SALEM, OREGON

T. 37S R. 18E Sec. Subdiv. N.F.

Mapped by Reviewed by Scale 2 inches = 1 Mile

- RESERVIOR
- DRAINAGE
- ROAD

Application No. R-62306
Permit No. R 9186

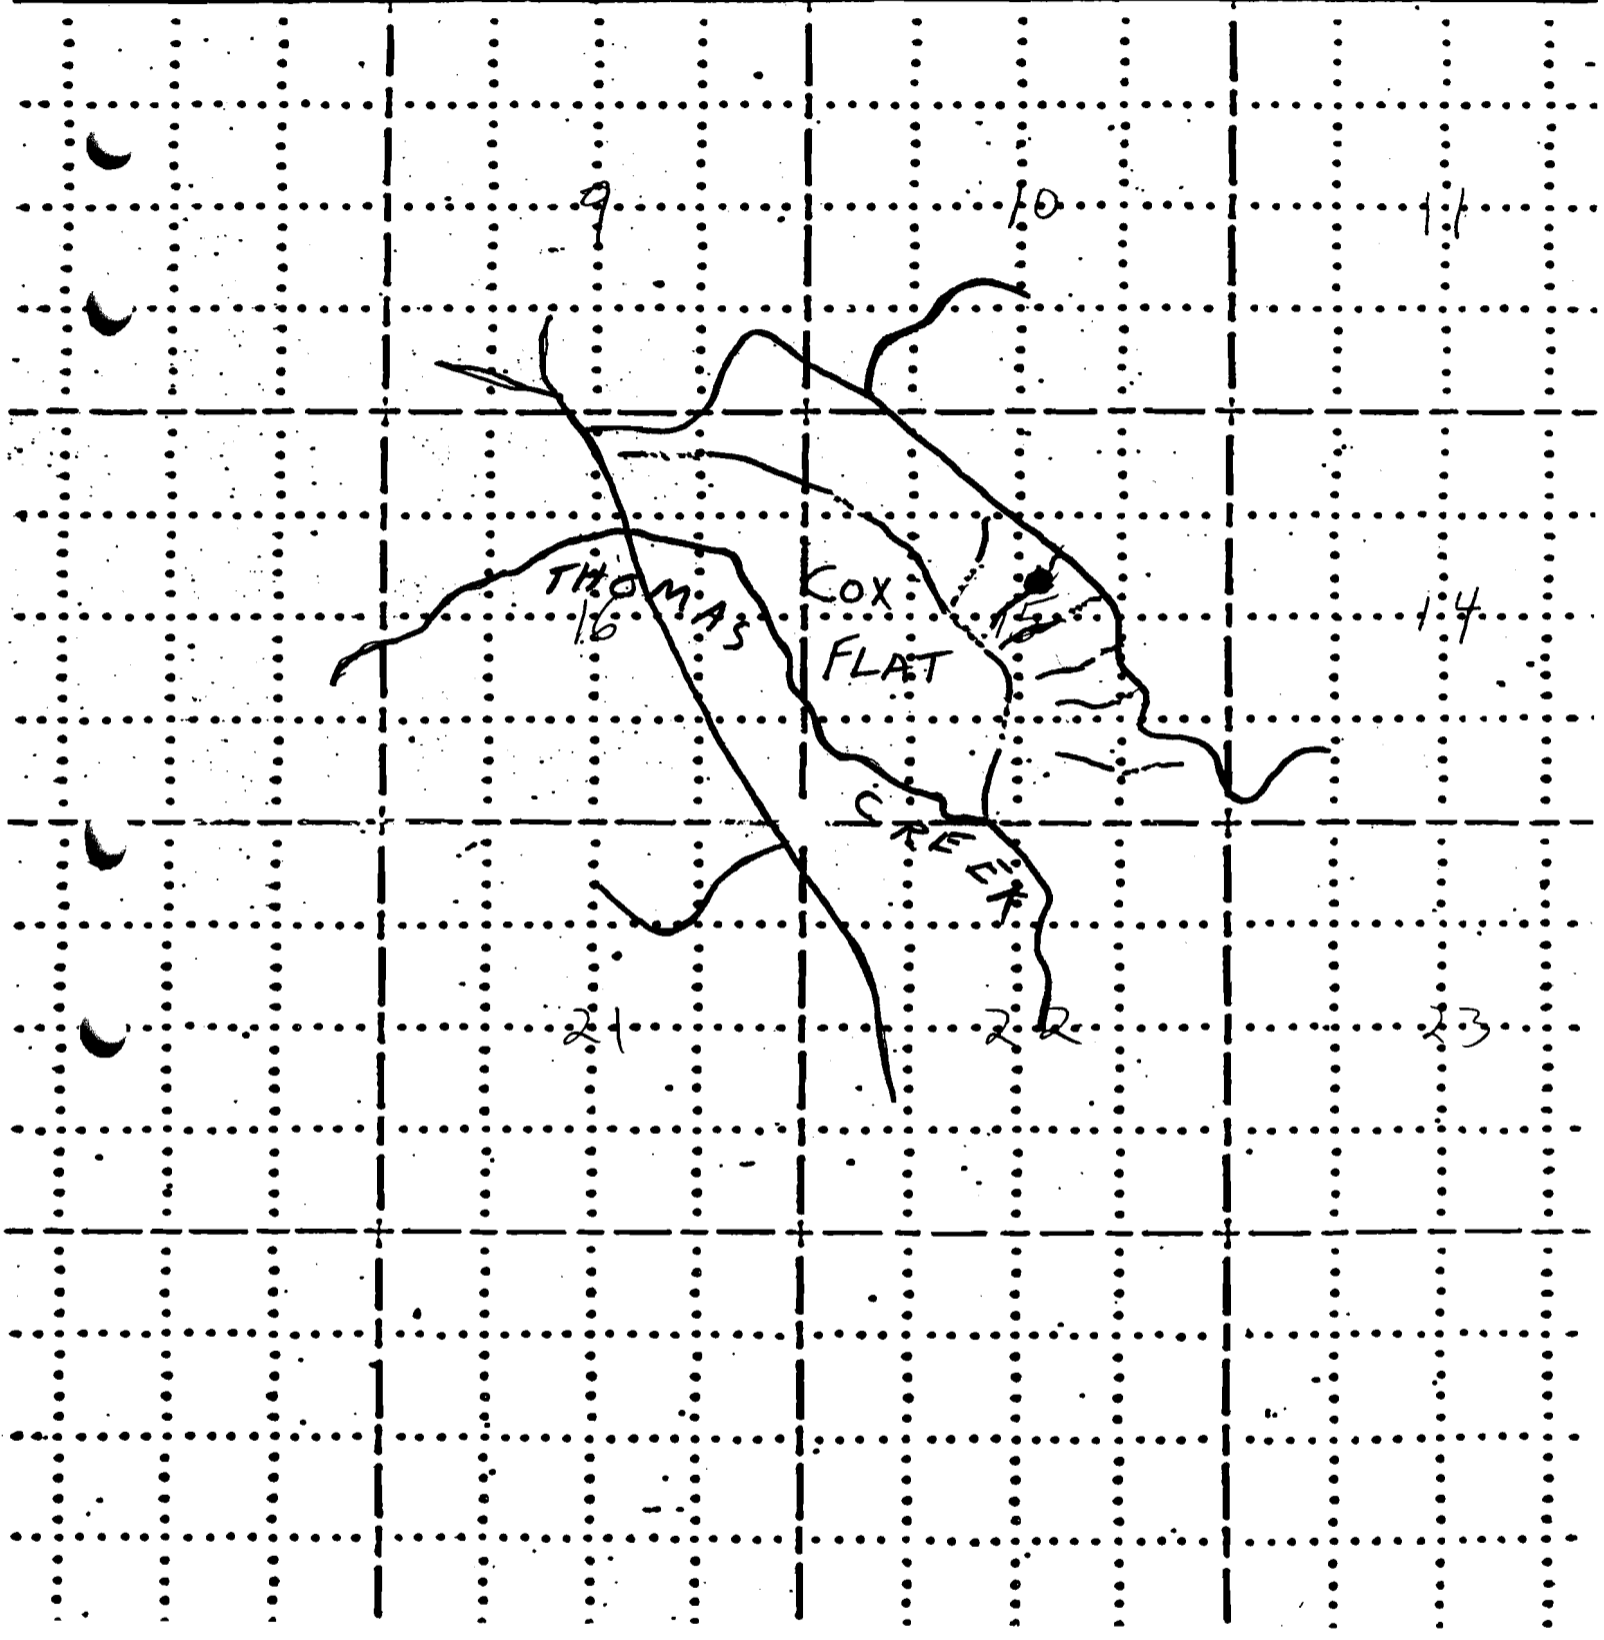

RECEIVED

AUG 14 1981

WATER RESOURCES DEPT
SALEM, OREGON

THOMAS CREEK W.G.

Application No. R-62306
Permit No. R 9186

Creek

Cox Flat

THOMAS CREEK

