

RECEIVED

R-9188
66994

AUG 14 1981


FIELD MAP SHEET WATER RESOURCES DEPT
SALEM, OREGON

T. 37S R. 20E Sec. Subdiv. N.F.

Mapped by Reviewed by Scale 2 inches = 1 Mile

- ROAD
- DRAINAGE
- RESERVOIR

Application No. R-62308, 19
Permit No. R 9188

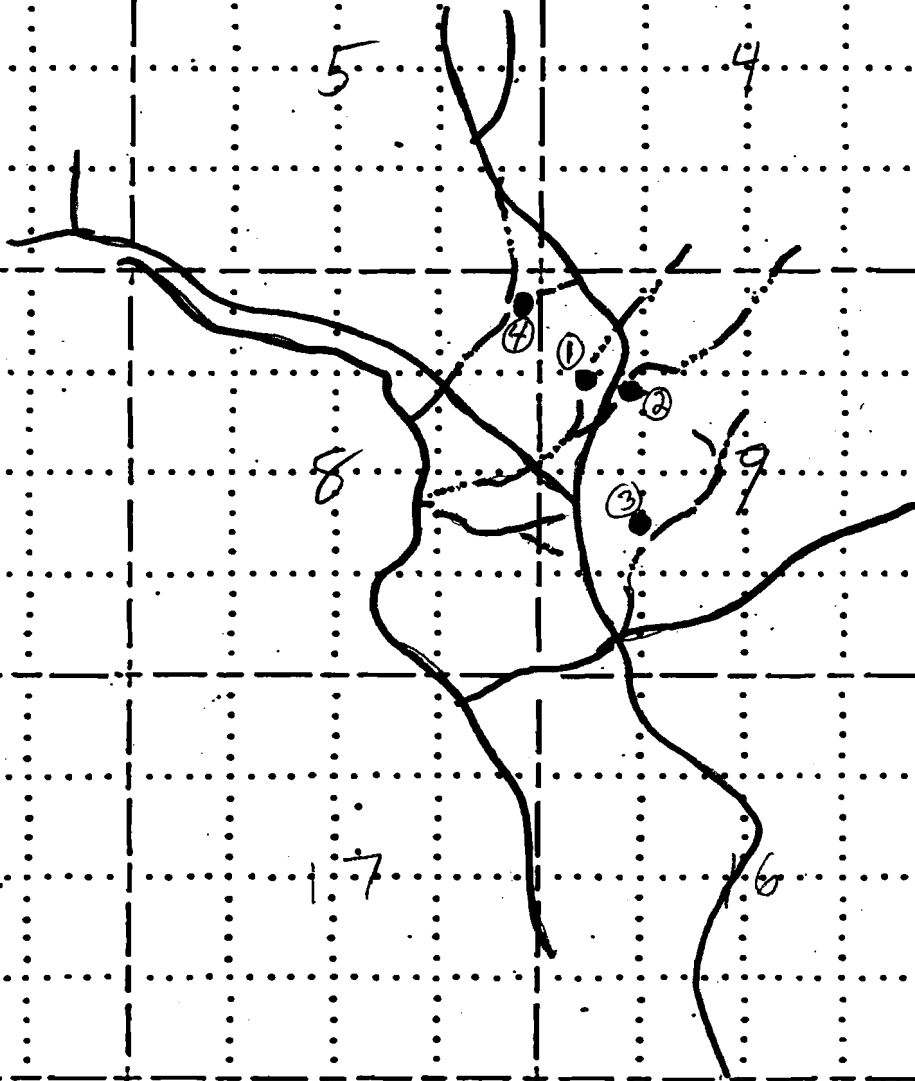

RECEIVED


AUG 14 1981

WATER RESOURCES DEPT
SALEM, OREGON

27
37 20 9,8

Application No. R-62308

Permit No. R 9188

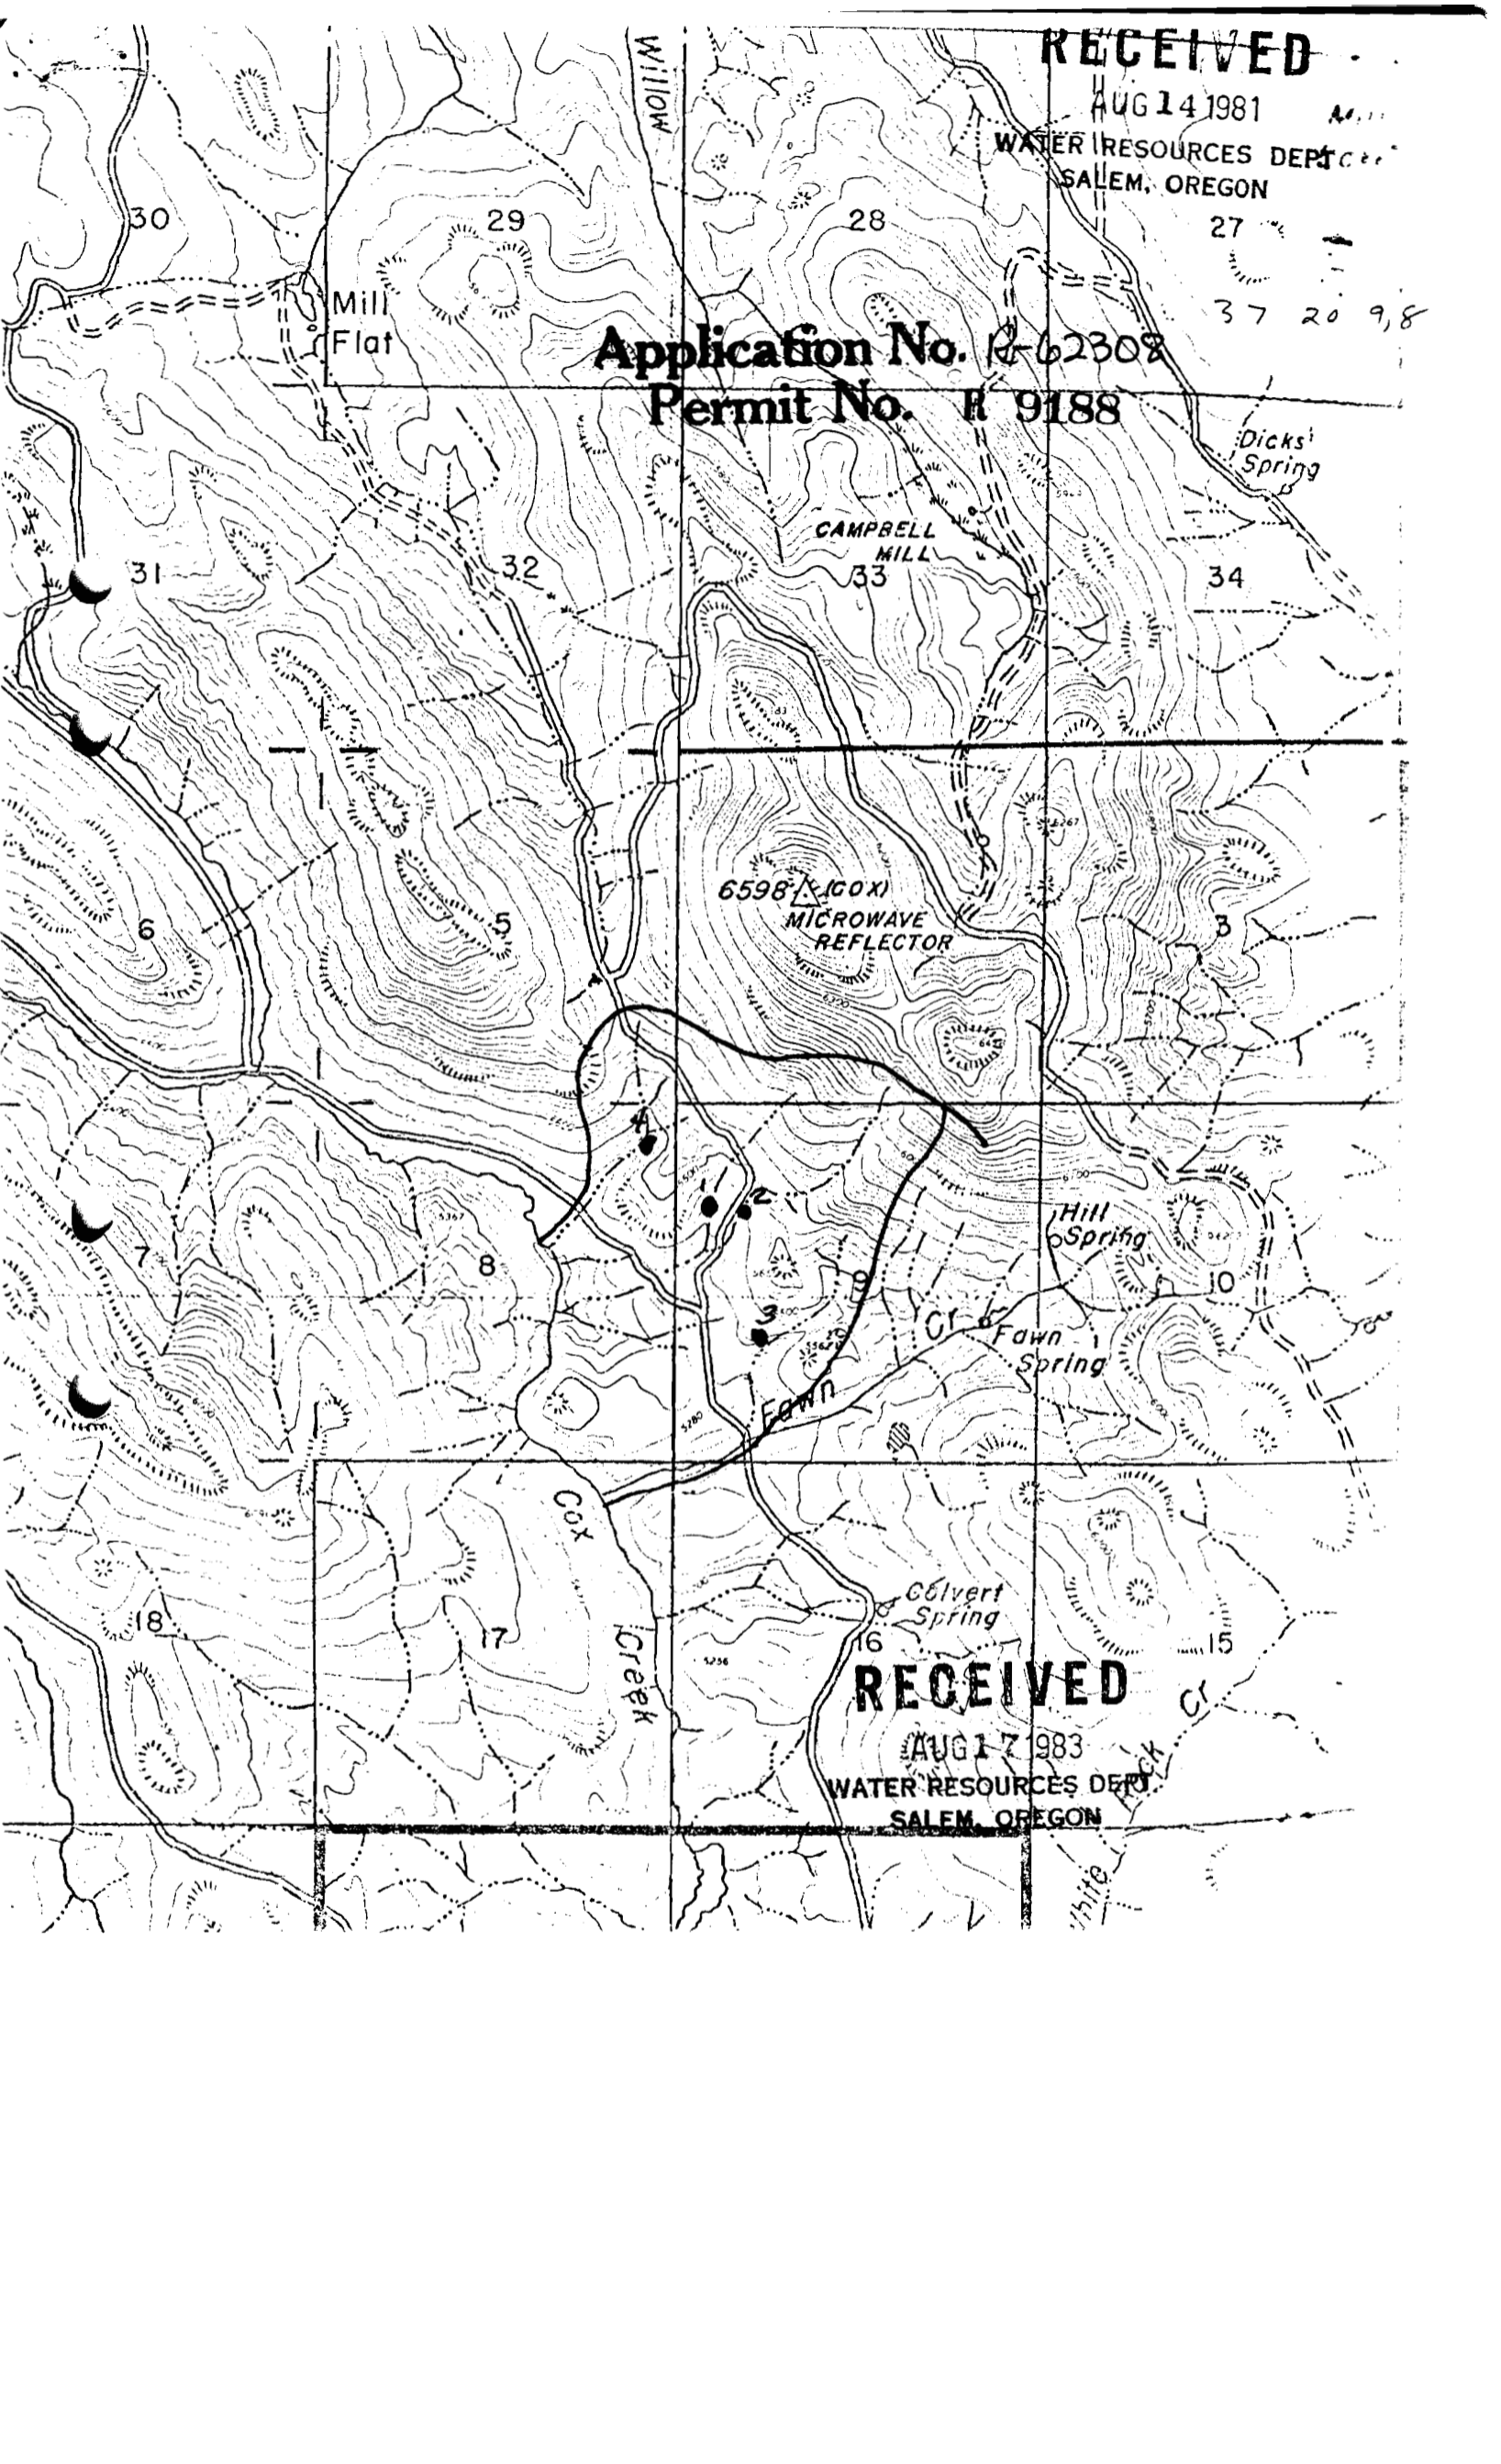

RECEIVED

AUG 17 1983

WATER RESOURCES DEPT
SALEM, OREGON