

RECEIVED

AUG 14 1981

R 9193
66997

FIELD MAP SHEET

WATER RESOURCES DEPT
SALEM, OREGON


T. 37S R. 20E Sec. Subdiv. N.F.

Mapped by Reviewed by Scale 2 inches = 1 Mile

— ROAD
— DRAINAGE
● RESERVOIR

Application No. R-62313

Permit No. R 9193

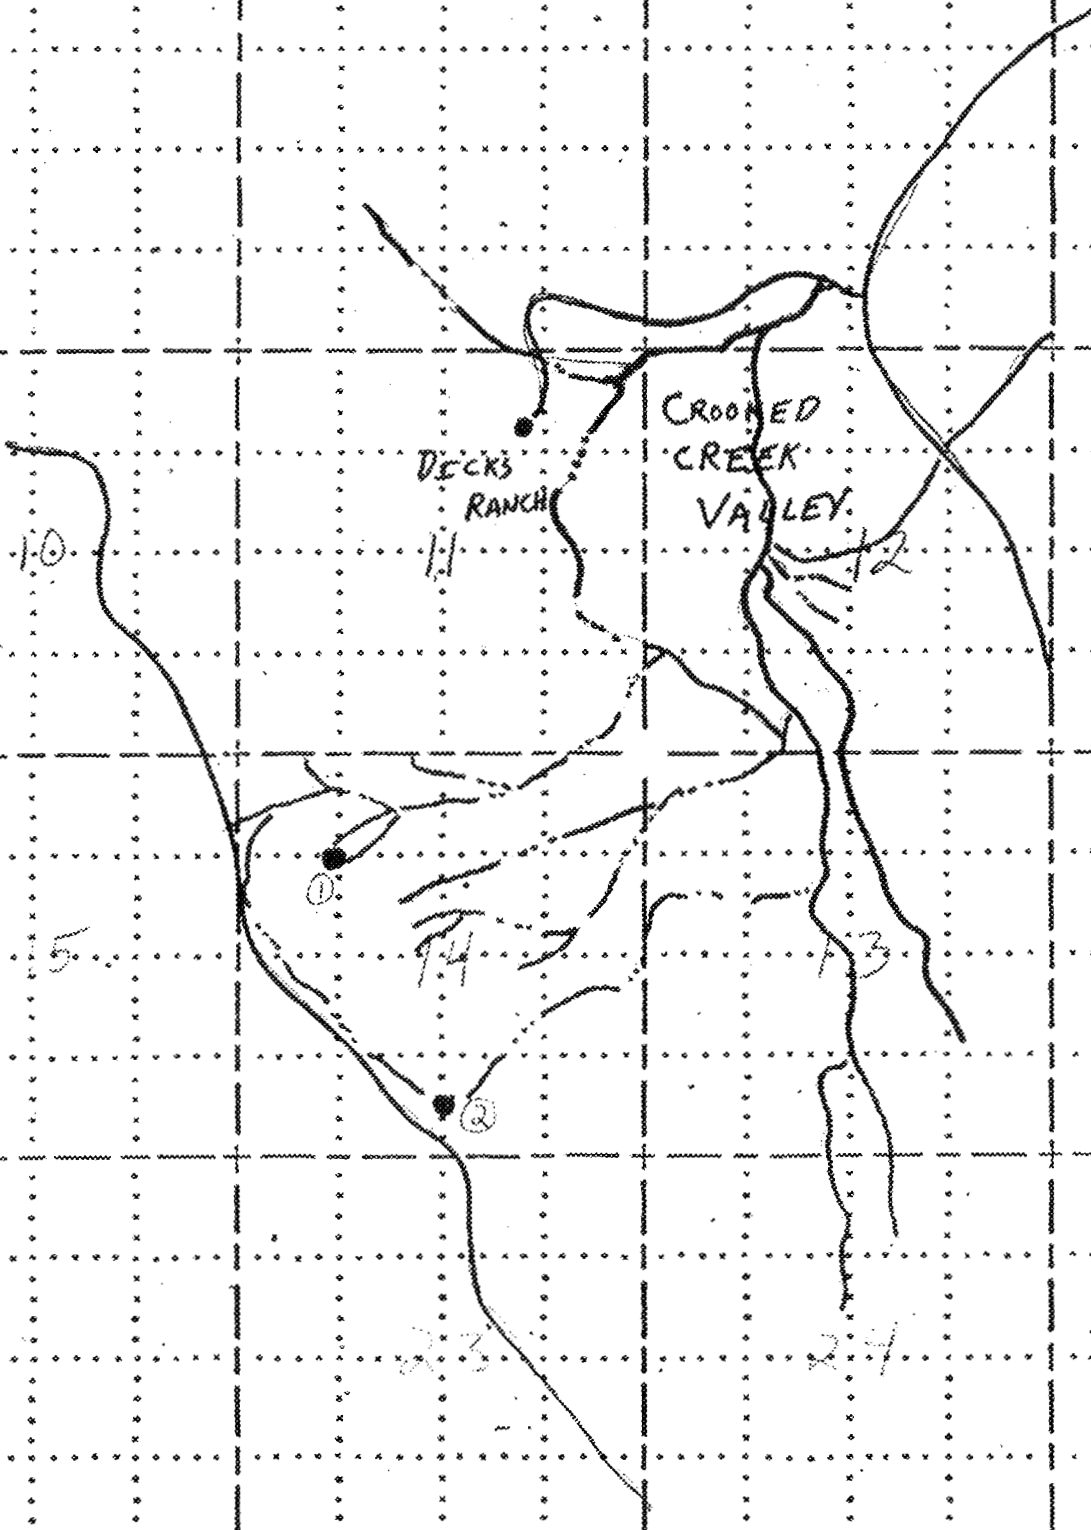

Application No. R-62313
Permit No. R 9193