

RECEIVED

AUG 14 1981

R9196
66999


FIELD MAP SHEET WATER RESOURCES DEPT
SALEM, OREGON

T. $\frac{36}{37} S$ R. 21E/22E Sec. Subdiv. N.F.

Mapped by Reviewed by Scale $\frac{2}{1}$ inches = 1 Mile

- ROAD
- DRAINAGE
- RESERVOIR

Application No. R-62316
Permit No. R 9196

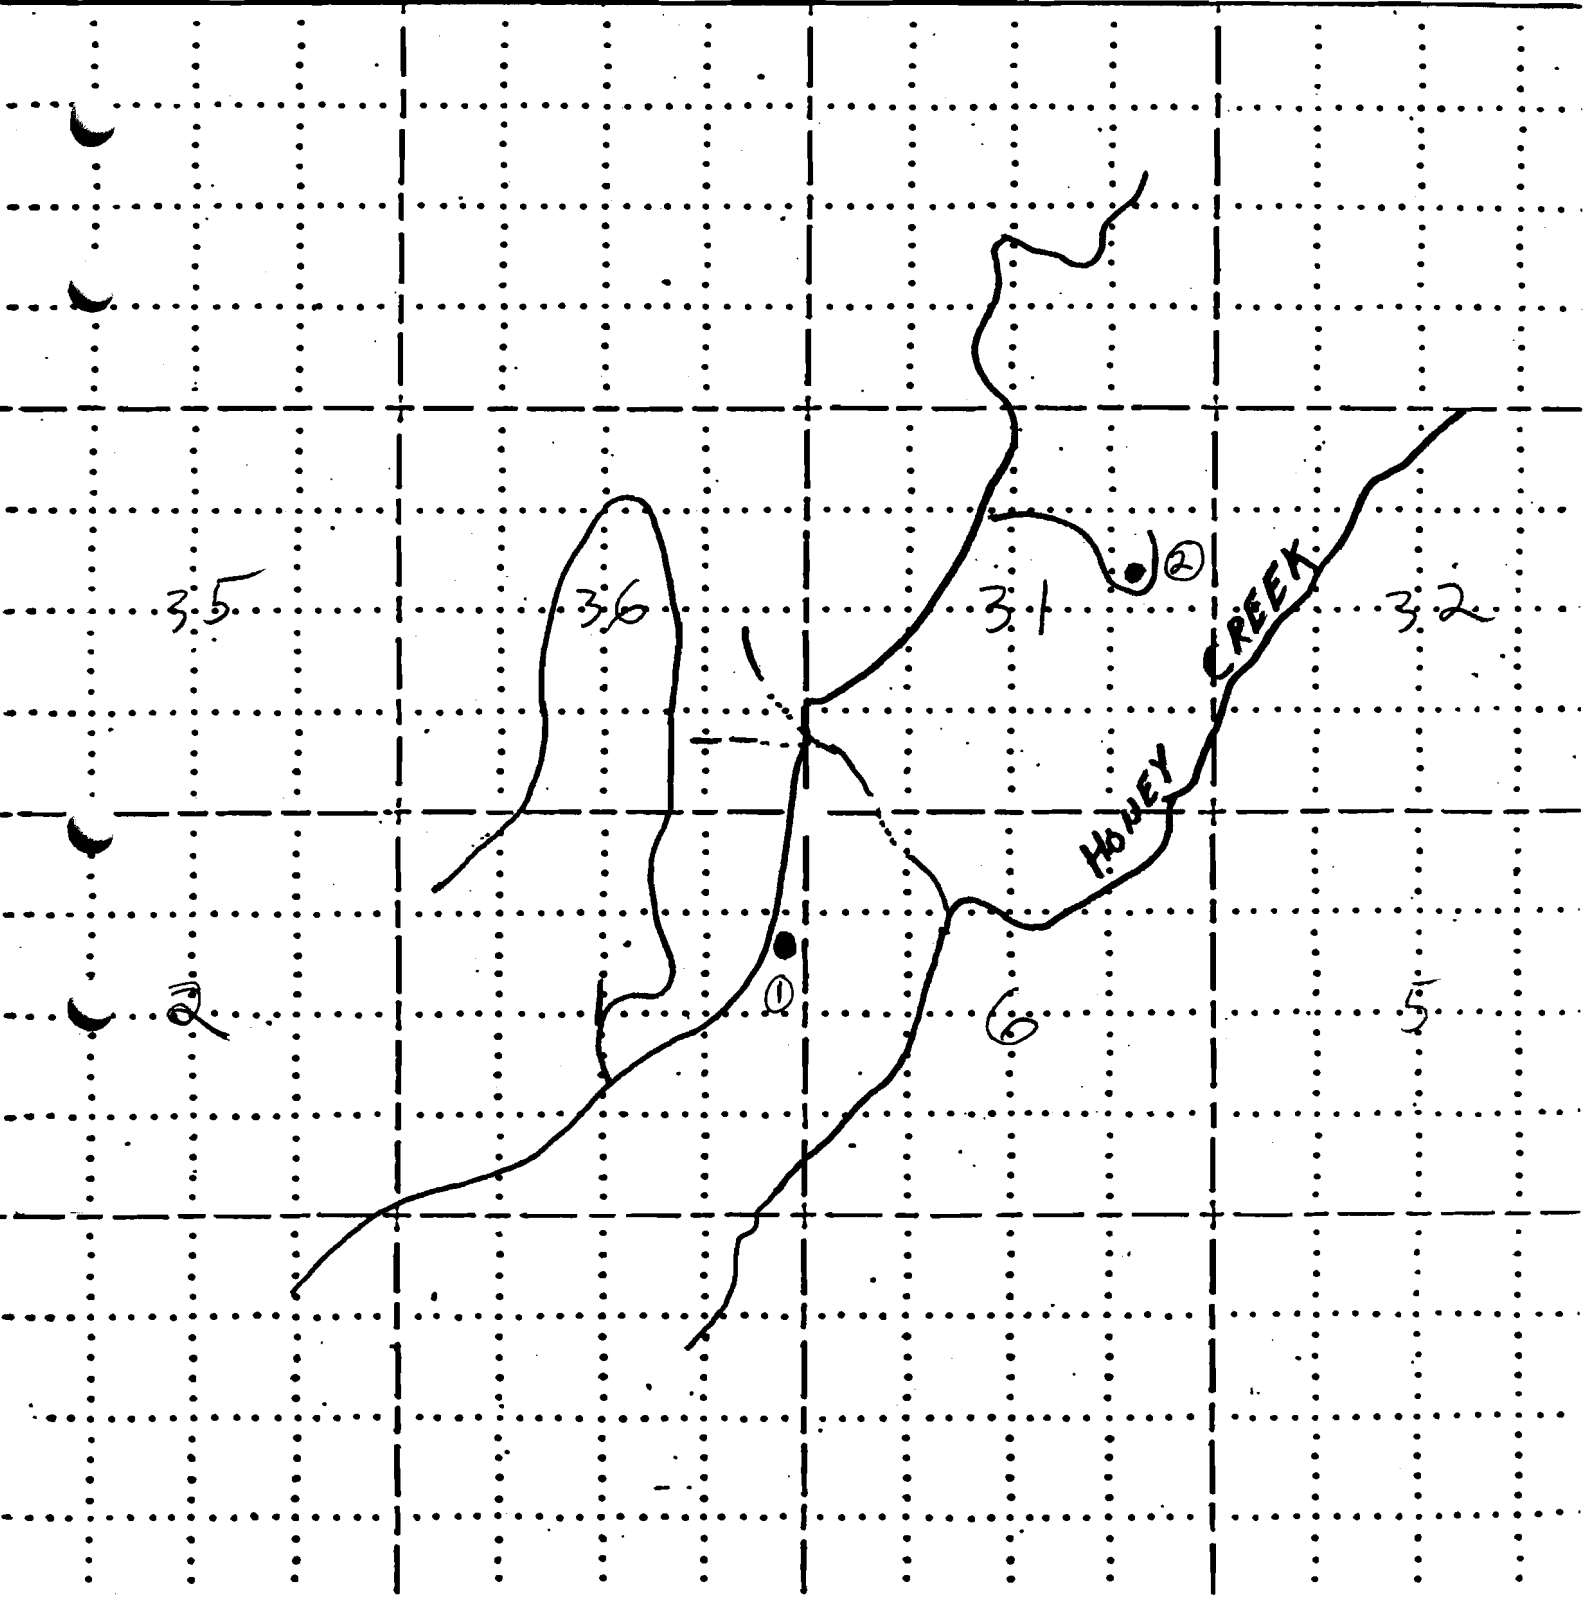

RECEIVED

AUG 14 1981

WATER RESOURCES DEPT
SALEM, OREGON

Application No. R-62316
Permit No. R 9196

