

Application No. R-62319
Permit No. R 9199

R. 9199
67001

RECEIVED


AUG 14 1981

WATER RESOURCES DEPT
SALEM, OREGON

(Lakeview 2)

(436)

T.37 S.

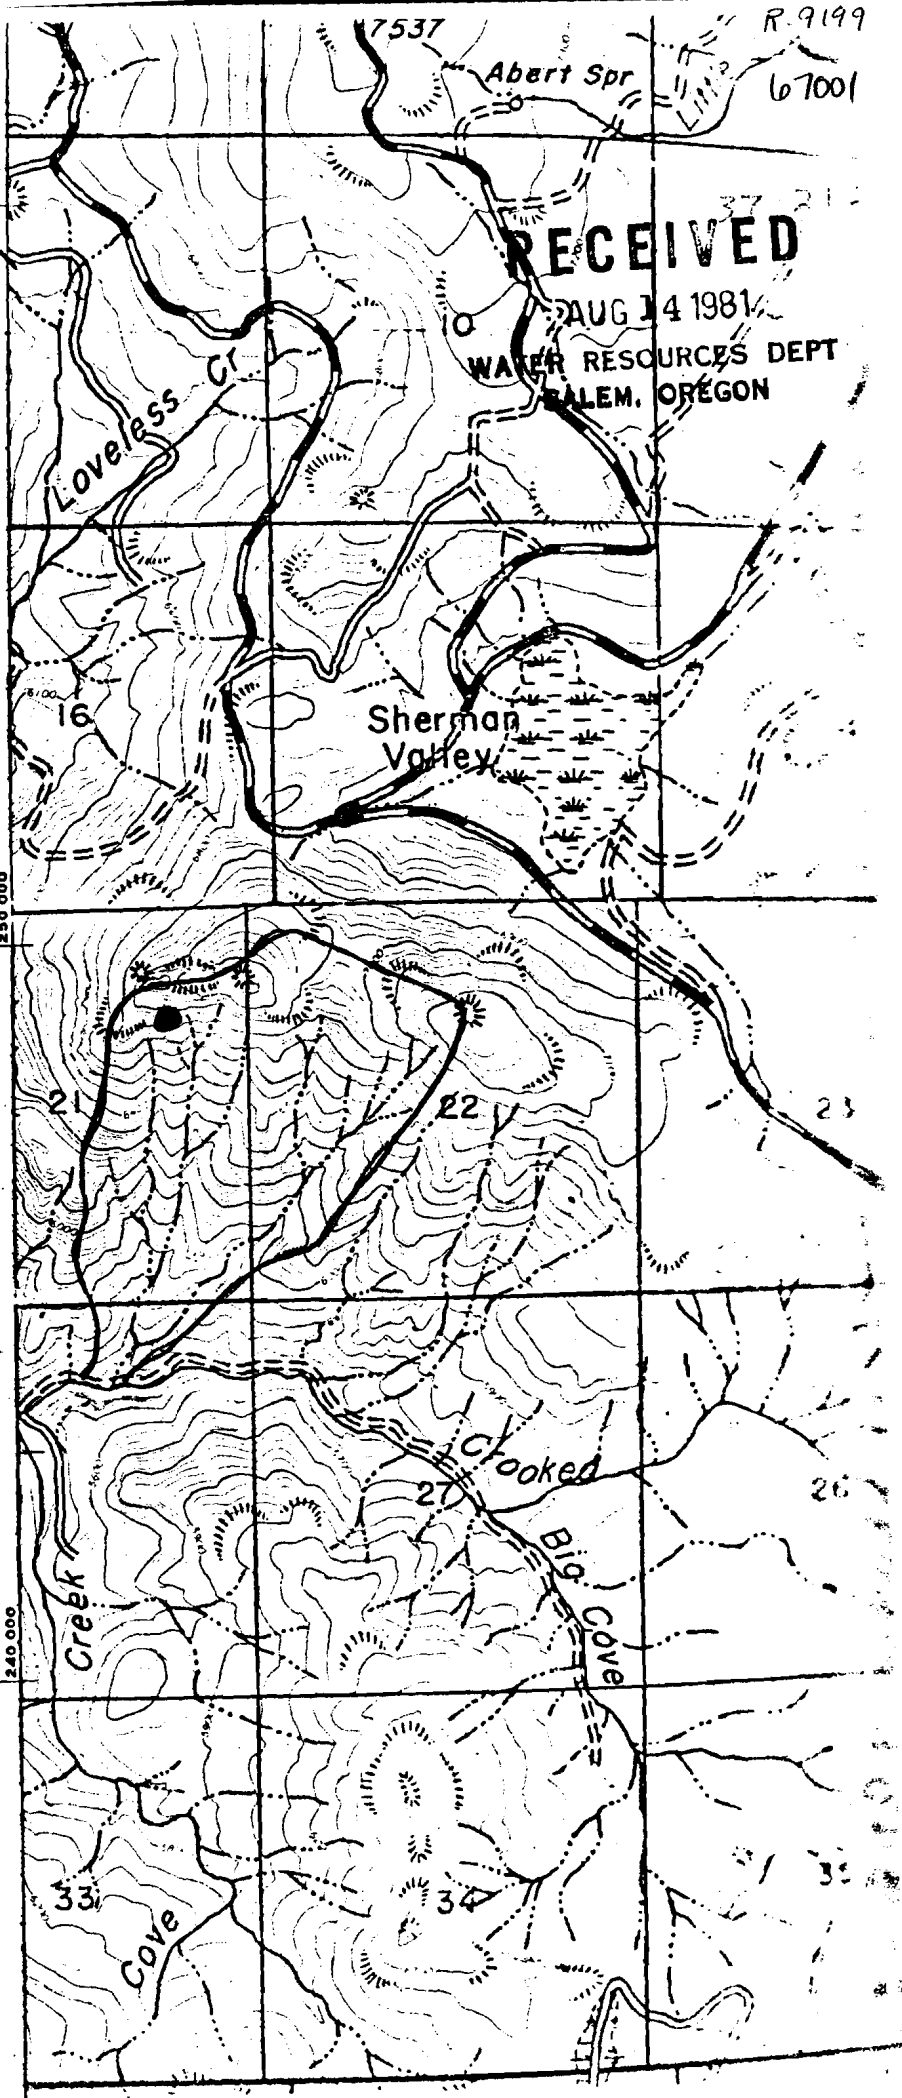

Application No. R-62319
Permit No. R 9199

