

R-9733

MALHEUR NATIONAL FOREST

STOCK WATER SW-26

allotment


Tp. 12S, R33E ROUNDTOP

SCALE 4 IN. : 1 MILE

North

application no. R-62887

permit no. R 9733

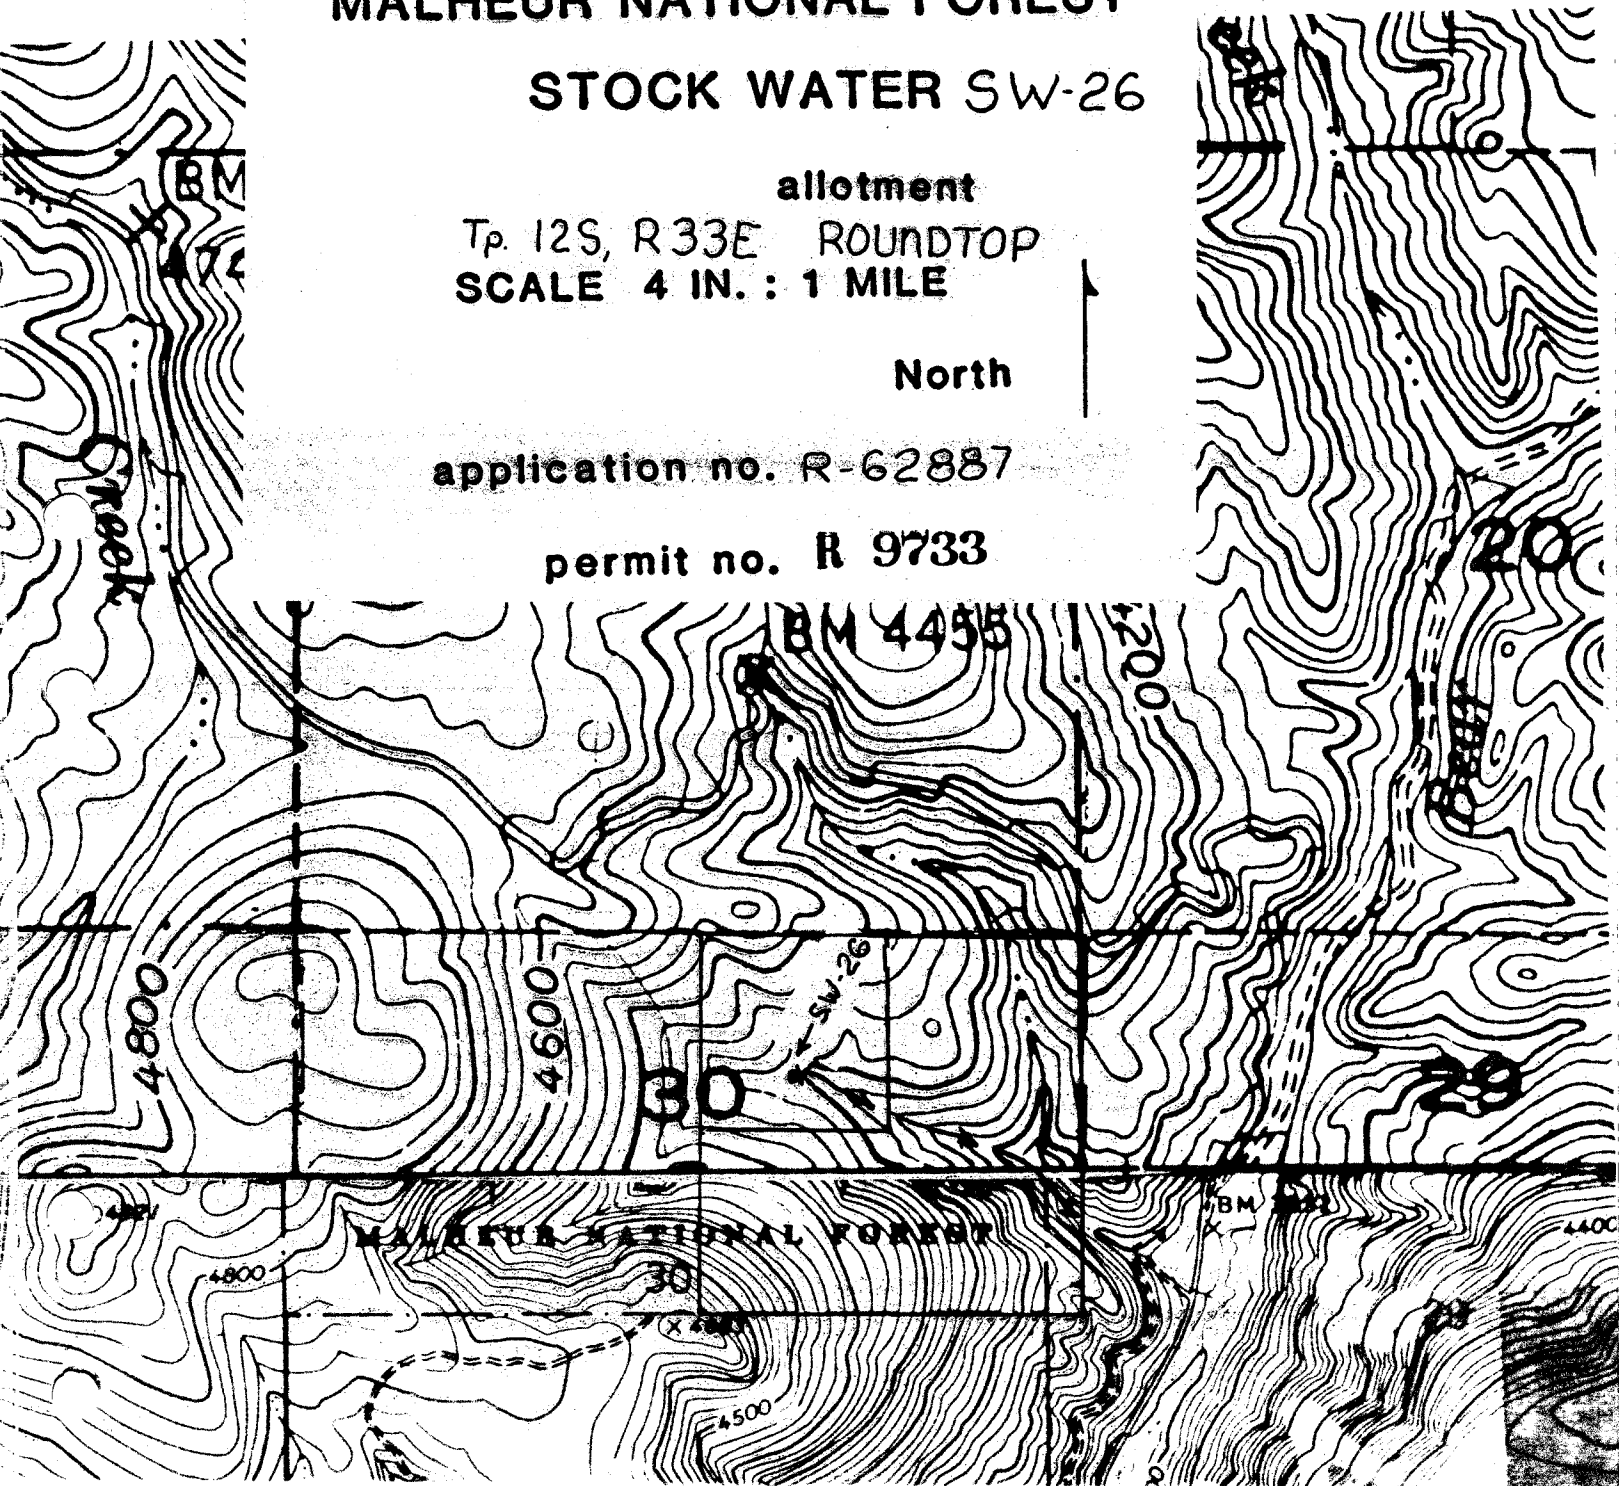

RECEIVED

JUN 15 1986

WATER RESOURCES DEPT.
SALMON, OREGON