

MALHEUR NATIONAL FOREST

R-9737

STOCK WATER SW-36

allotment


Tp. 12S, R 32E ROUNDTOP

SCALE 4 IN. : 1 MILE

North

application no. R-62891

permit no. R 9737

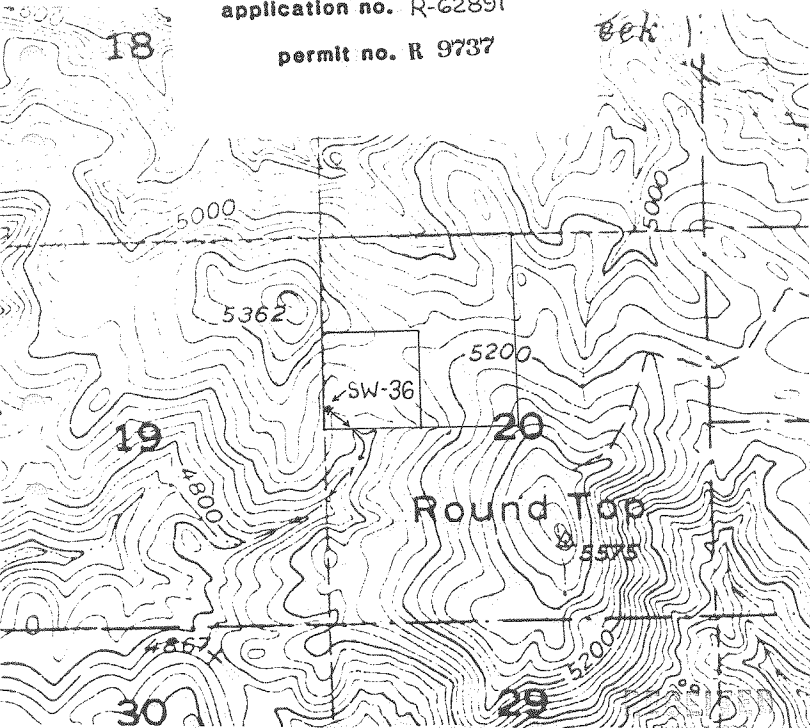

WATER RESOURCES DEPT.
SALEM, OREGON