

MALHEUR NATIONAL FOREST


STOCK WATER SW-1

TN 10S R4 30E allotment
Highway
SCALE 4 IN. : 1 MILE

North

application no. R-62895

permit no. R 9740

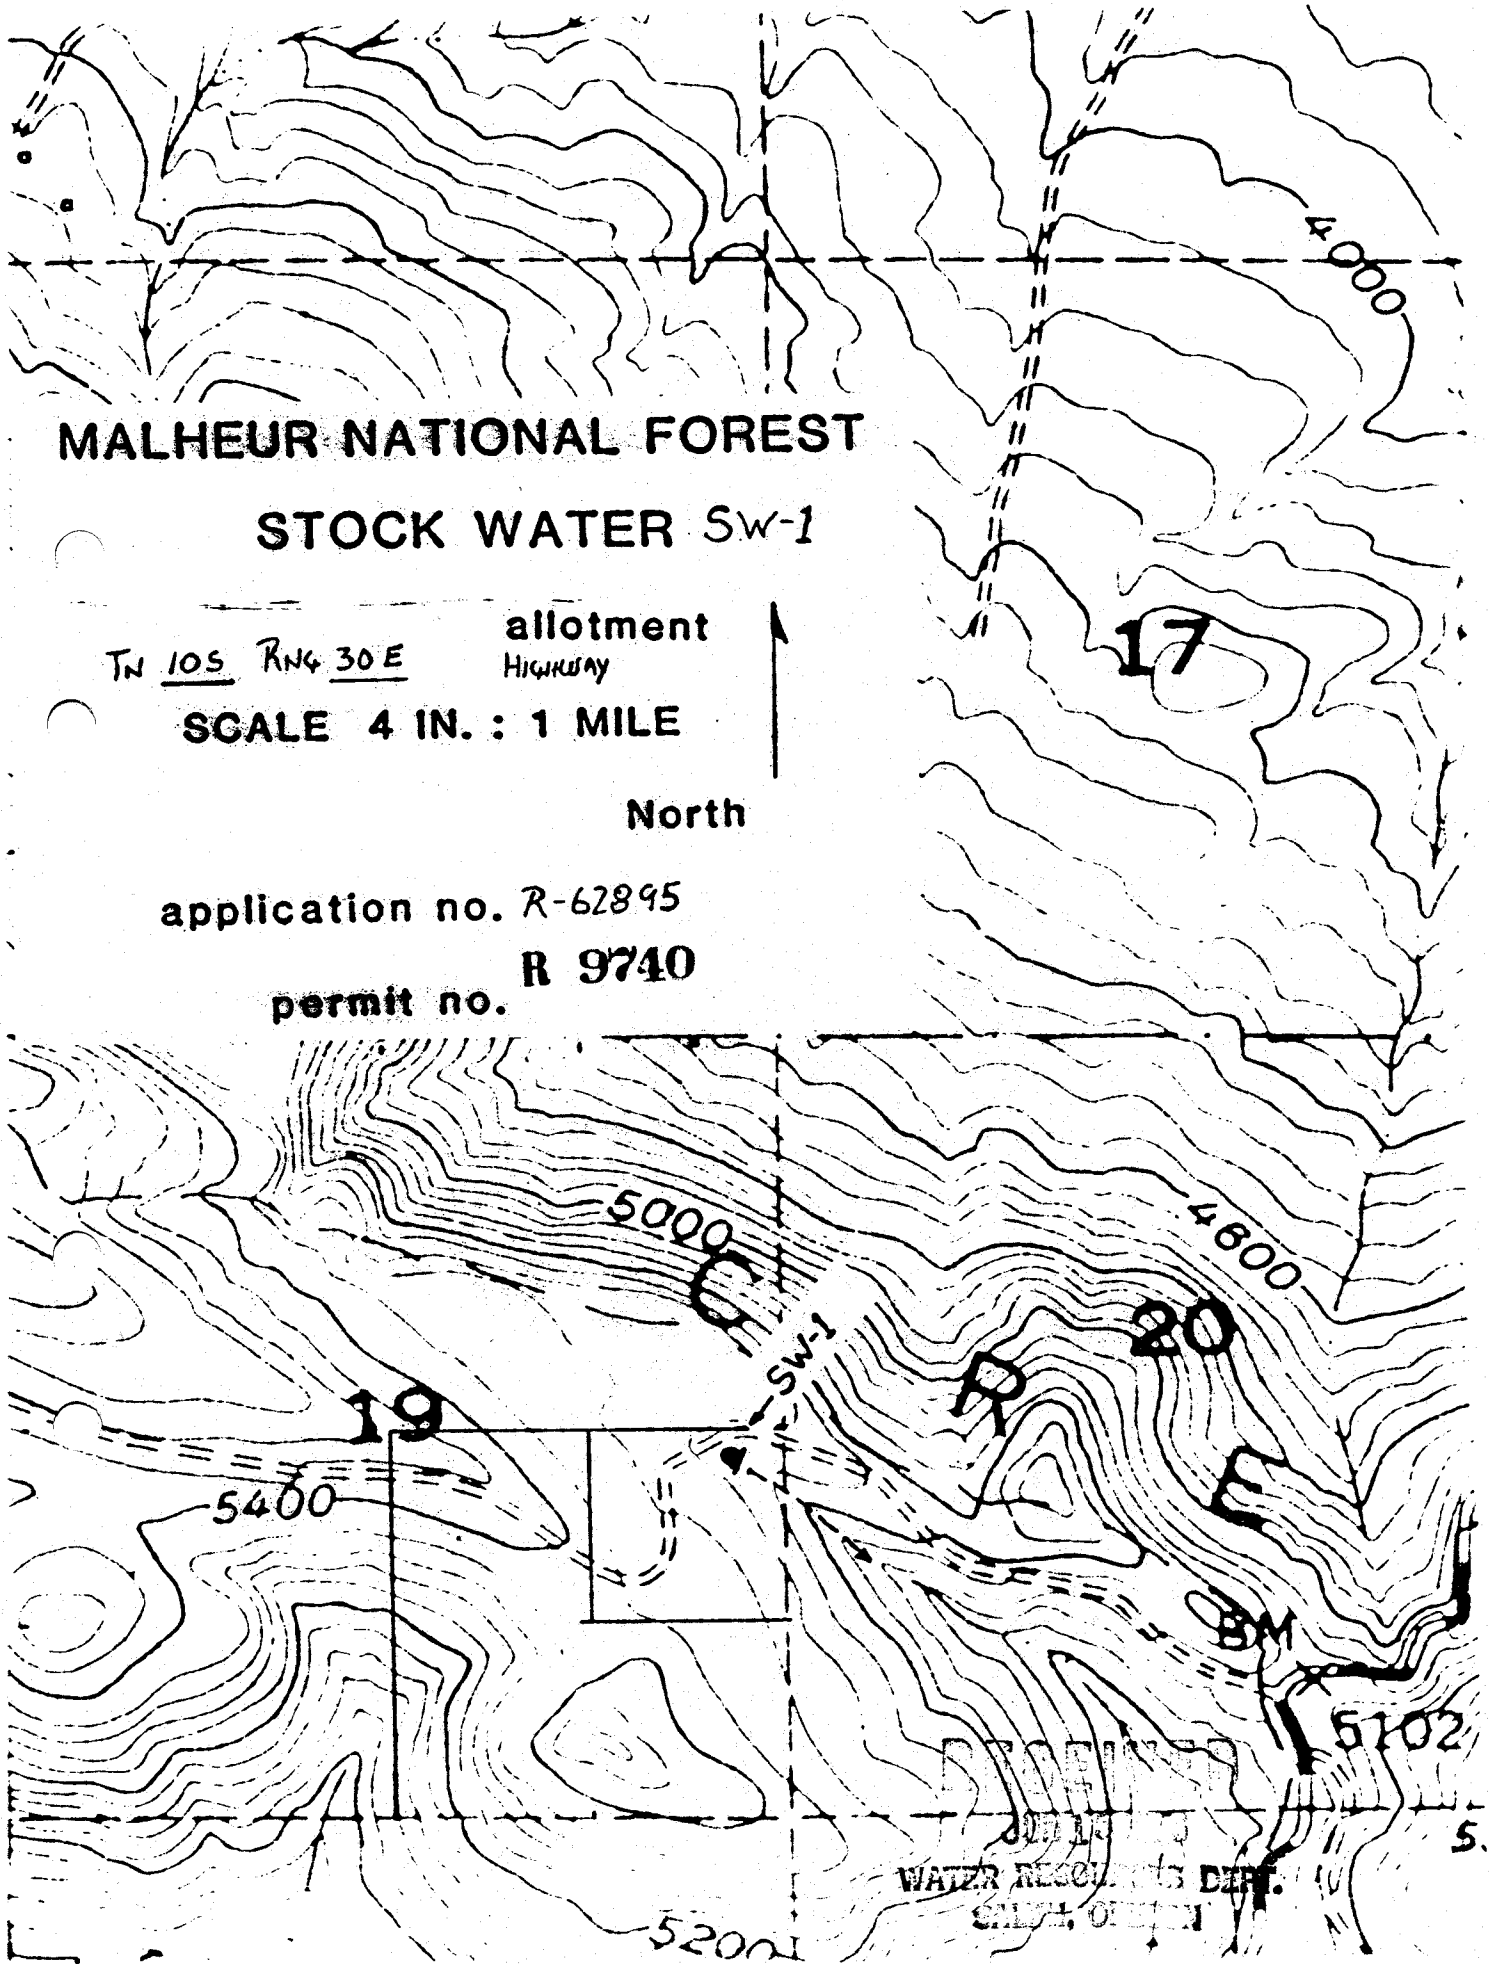

WATER RESOURCES DIV.
