


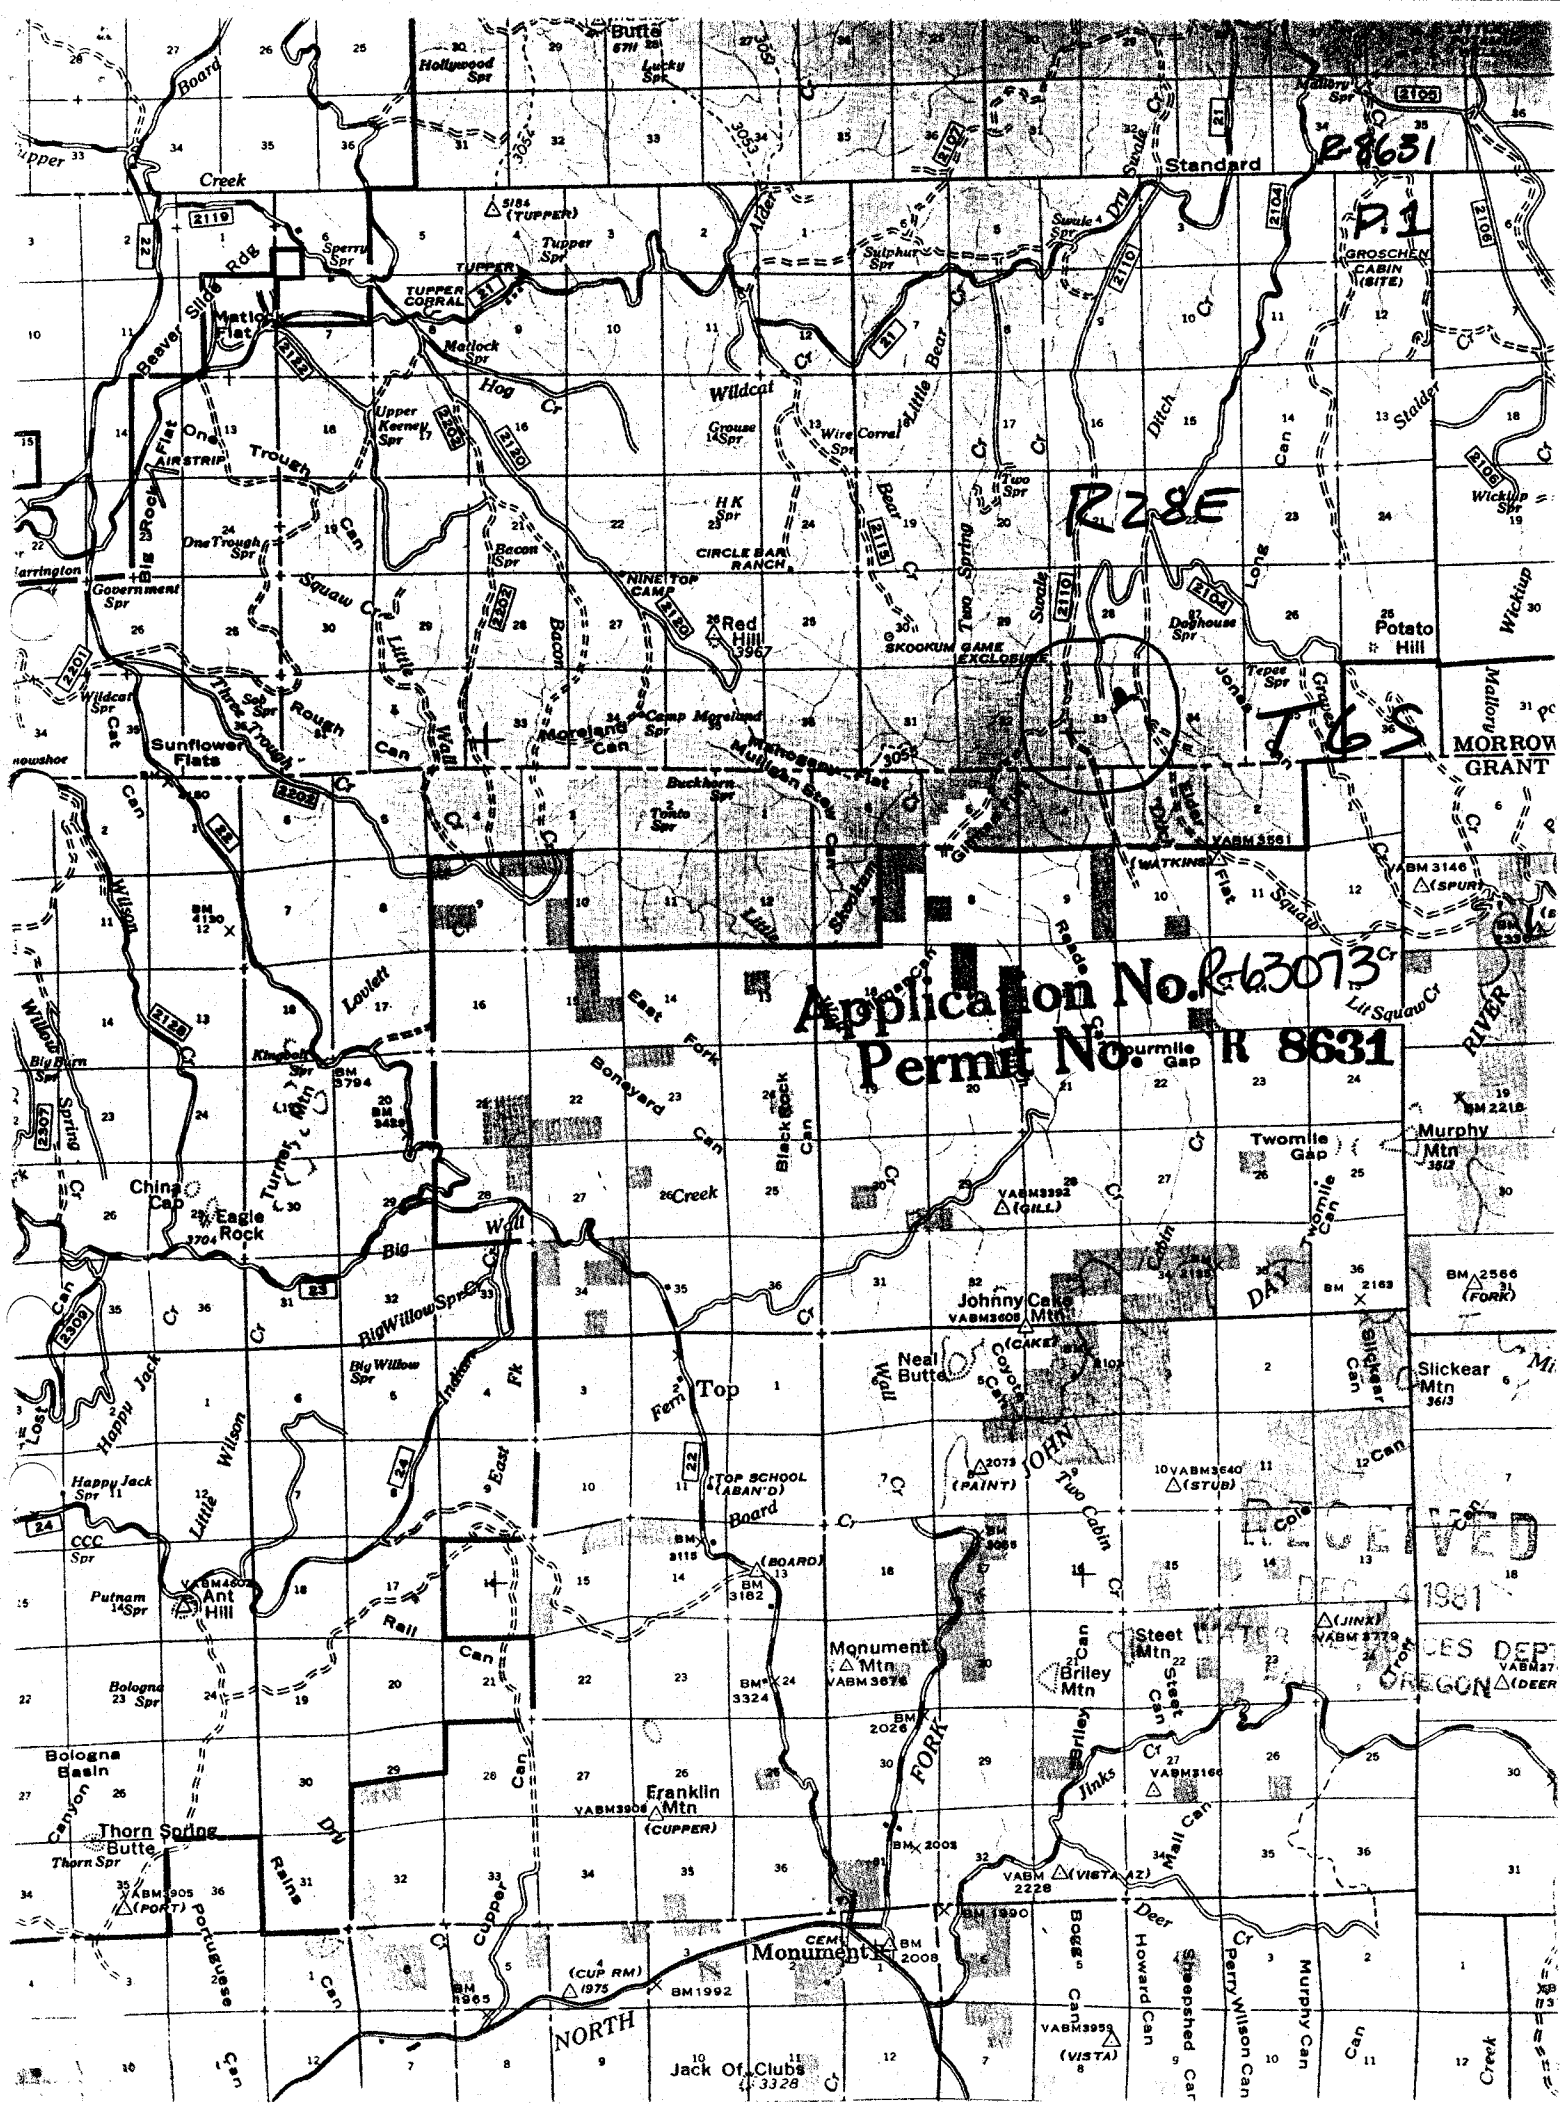

TOWNSHIP

65

, RANGE

28E

, SECTION

33

, W.M.

P.2

R-8631

28

27

Application No. R-63073
Permit No. R 8631

33

34

RECEIVED

FEB 28 1983

WATER RESOURCES DEPT.
SALEM, OREGON

NAME

North Elder Flat Res.

COUNTY

Morrow

RECEIVED

DEC 4 1981

WATER RESOURCES DEPT.
SALEM, OREGON