


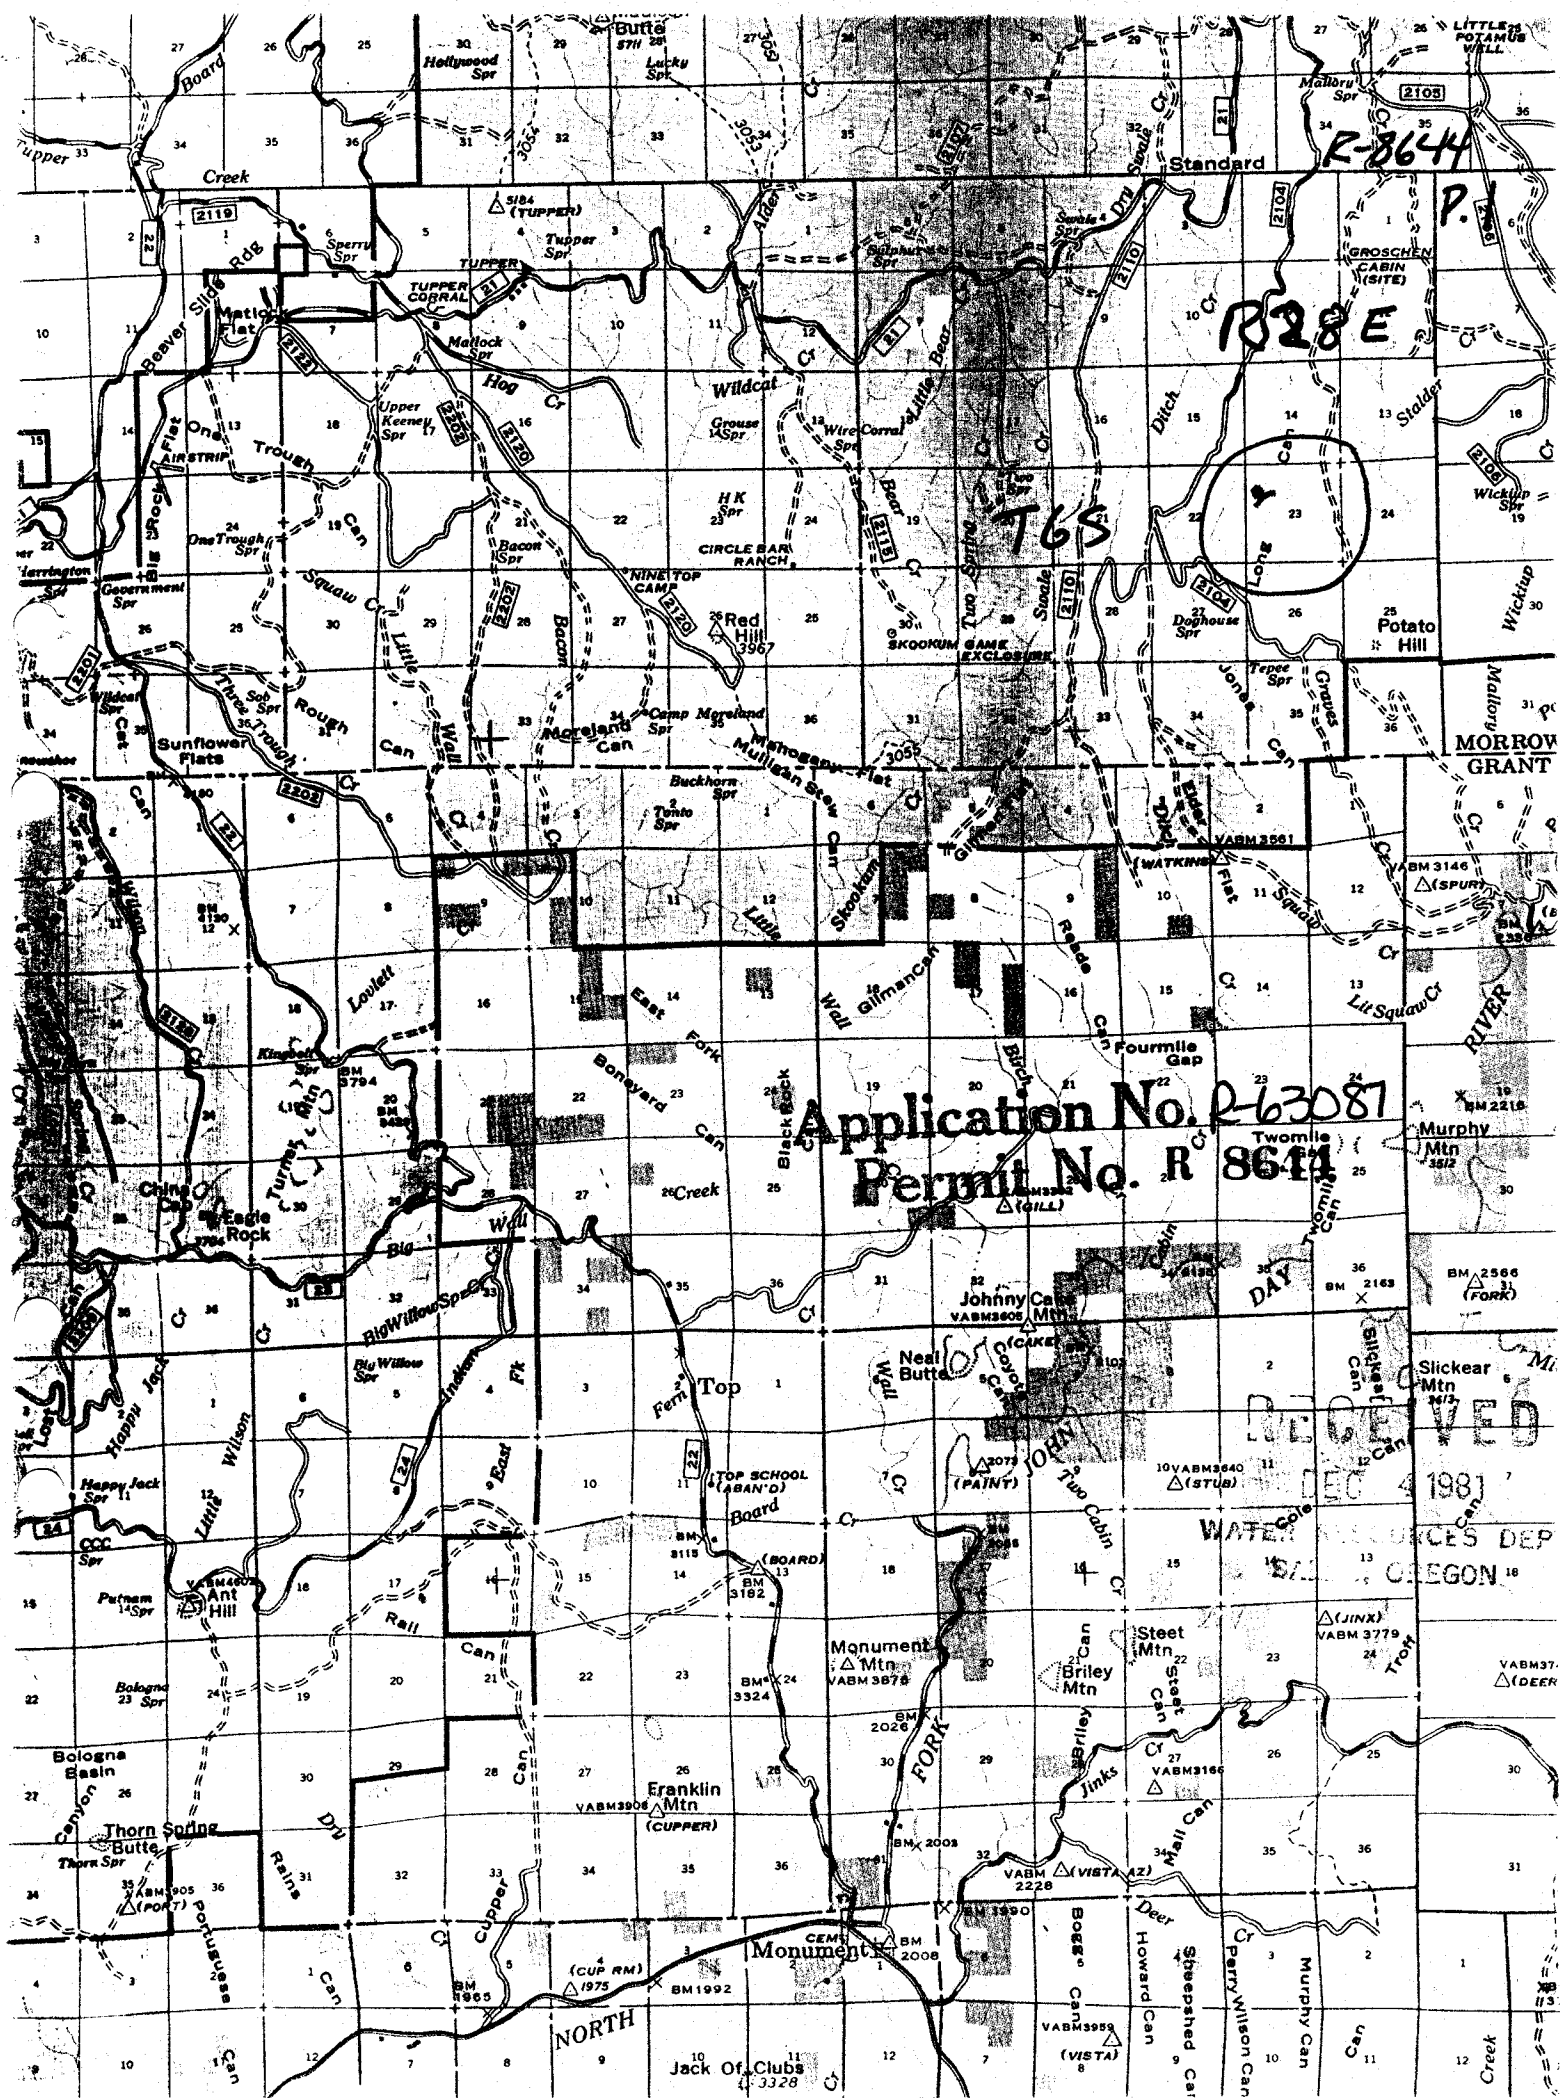

R-8644

TOWNSHIP 6 S, RANGE 28 E, SECTION 23, W.M. P.2

15

14

Application No. R-63087
Permit No. R 8644

22

23

NAME Teton Res. COUNTY Morrow

RECEIVED
DEC 4 1981
WATER RESOURCES DEPT
