


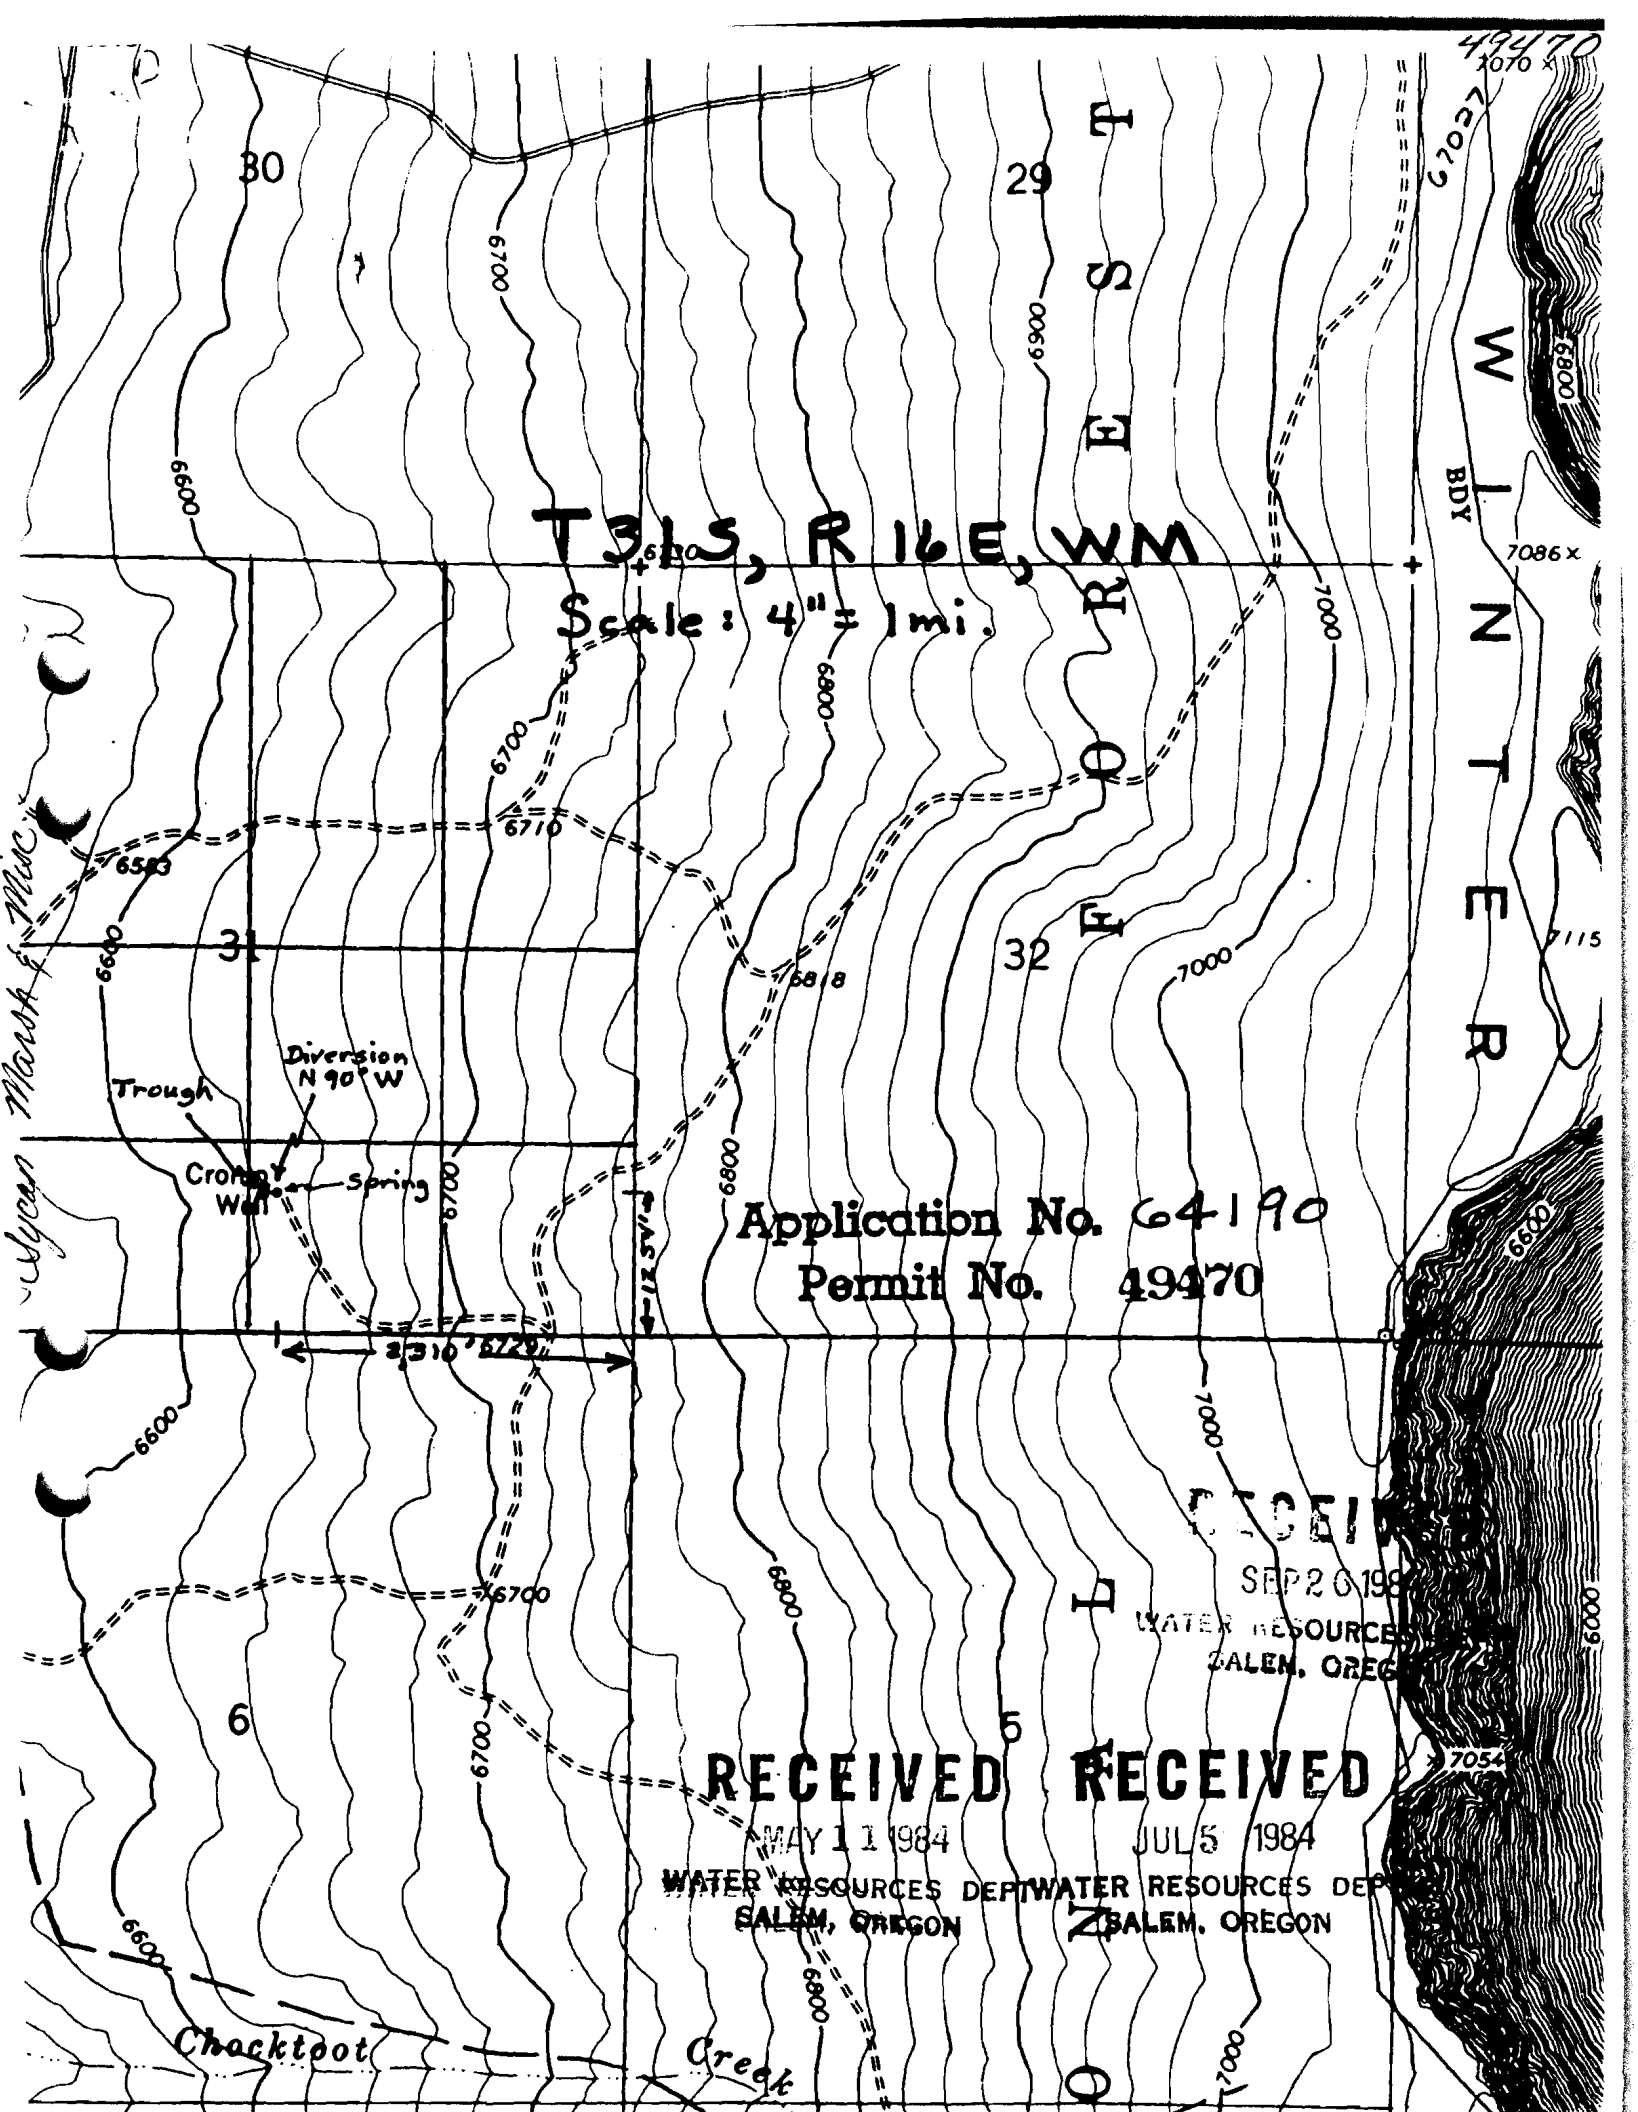

T31S, R16E, WM

Scale: 4" = 1 mi.

Application No. 64190

Permit No. 49470

RECEIVED

SEP 20 1984

WATER RESOURCES DEPT
SALEM, OREGON

RECEIVED

MAY 11 1984

WATER RESOURCES DEPT
SALEM, OREGON

RECEIVED

JUL 5 1984

WATER RESOURCES DEPT
SALEM, OREGON

Chacktoot

Creek